PROJECT	DESIGNATION
STP-4075(3)	8916700
CONTRACT	BRIDGE FILE
B-23076	8-75-4883B

INDEX

STRUCTURE	TYPE	SPAN AND SKEW	OVER	STATION
8-75-4883B	CONTINUOUS STEEL BEAM BRIDGE	49' LT., 5 SPANS 10538, 18636, 21946, 18636, 10538	YELLOW RIVER	61+64.58

SHEET NO.	SUBJECT
1	TITLE SHEET
2-3	DETOUR DETAILS
4	LAYOUT
5-6	GENERAL PLAN
7	REMOVAL DETAILS
8-9	BENTS NO. 1 AND NO. 6 DETAILS
10	BENTS NO. 2 AND NO. 5 DETAILS
11-12	STRUCTURAL STEEL DETAILS
13	BEARING DETAILS
14-15	SUPERSTRUCTURE DETAILS
16-17	CONCRETE BRIDGE RAIL DETAILS
18-19	R.C. BRIDGE APPROACH DETAILS
20	SUMMARY

B-23076

INDIANA DEPARTMENT OF TRANSPORTATION

BRIDGE PLANS

FOR SPANS OVER 6 METERS


ON STATE ROAD NO. 8

PROJECT NO. STP-4075(3) CONST.

REFERENCE POINT 35+82

SUPERSTRUCTURE RECONSTRUCTION FOR BRIDGE ON S.R. 8 OVER YELLOW RIVER APPROXIMATELY 2.1 km WEST OF S.R. 23; LOG MILE : 12.18, LOCATED IN SECTIONS 20 & 29, T 33 N, R 1 W, WASHINGTON TOWNSHIP, STARKE COUNTY, INDIANA

STRUCTURE: 8-75-4883B
SUPERSTRUCTURE RECONSTRUCTION FOR PRESENT STRUCTURE: 8-75-4883A

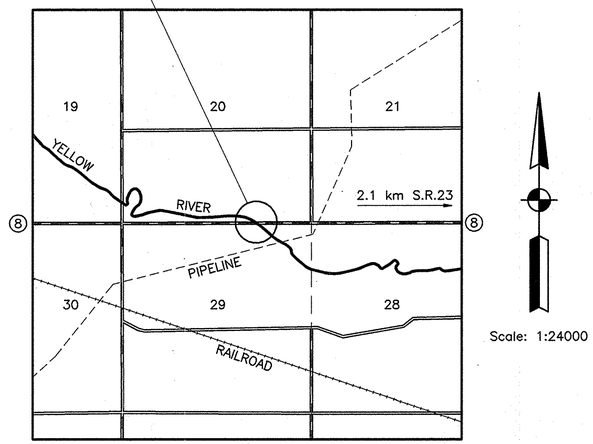

Scale: 1:24000

T 33 N, R 1 W
WASHINGTON TOWNSHIP
STARKE COUNTY
INDIANA

TRAFFIC DATA	
A.A.D.T.	2700 V.P.D.
A.A.D.T.	V.P.D.
D.H.V.	V.P.H.
DIRECTIONAL DISTRIBUTION	%
TRUCKS	% D.H.V.
	% A.A.D.T.
DESIGN DATA	
DESIGN SPEED	90 K.P.H.
PROJECT DESIGN CRITERIA	3R (NON-FREEWAY)
FUNCTIONAL CLASSIFICATION	STATE COLLECTOR
RURAL/URBAN	RURAL
TERRAIN	LEVEL
ACCESS CONTROL	



PROJECT LOCATION SHOWN BY

BRIDGE LENGTH :	KM.
ROADWAY LENGTH :	KM.
TOTAL LENGTH :	KM.
MAX. GRADE :	%

[INDIANA DEPARTMENT OF TRANSPORTATION STANDARD SPECIFICATIONS DATED 1995 TO BE USED WITH THESE PLANS]

DWG. FILE: 9523TIT


REVISIONS	
DATE	SHEET NO.

FEDERAL HIGHWAY ADMINISTRATION
U.S. DEPT. OF TRANSPORTATION
APPROVED: _____ DATE
DIVISION ADMINISTRATOR

PLANS PREPARED BY: FLOYD E. BURROUGHS & ASSOC., INC
5160 EAST 65TH STREET (317) 849-9722
INDIANAPOLIS, INDIANA 46220 PHONE NUMBER
CERTIFIED BY: Frank E. Sailer Jr. 2-5-97 DATE
APPROVED FOR LETTING: Phillip H. Kiefer 2/27/97 DATE
CHIEF, DIVISION OF DESIGN

FRANK EDWARD SAILER JR. REGISTERED No. 21453 STATE OF INDIANA PROFESSIONAL ENGINEER

	BRIDGE FILE
	8-75-4883B
	DESIGNATION
	8916715
	SHEETS
	1 of 20
CONTRACT	PROJECT
	STP-4075( )

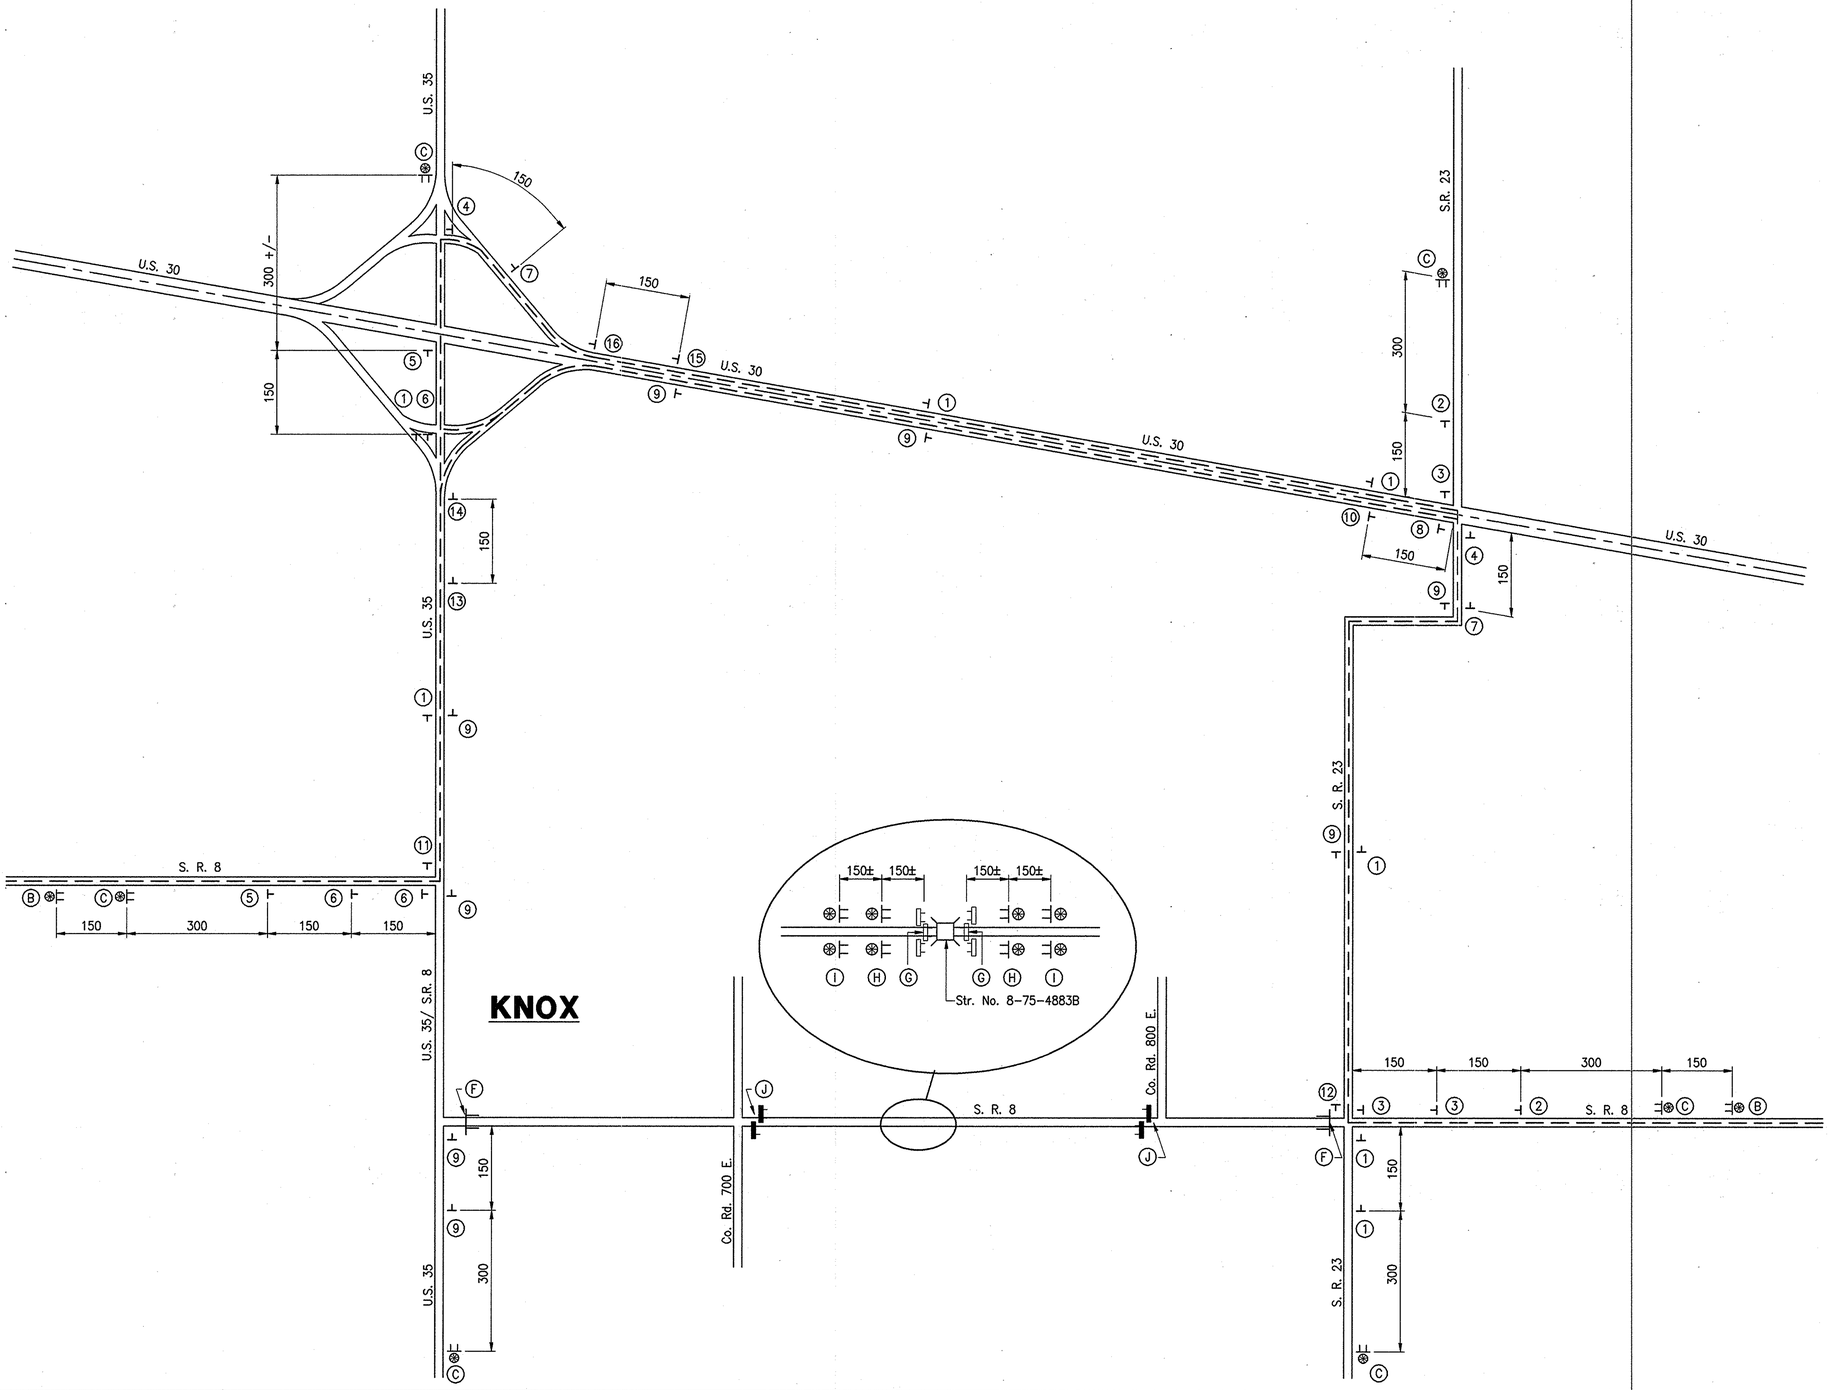

LEGEND

- Detour Route Marker Assembly
- S.R. 8 Detour Route
- Standard Barricade Type III-A
- Standard Barricade Type III-B
- Type "A" Construction Warning Light
- Type "B" Construction Warning Lights
- Typical Sign Standard

NOTES:

All Dimensions Shown In Meters.

For Sign Legend, See Sheet 3.

Drwg. File: 9523DET1.DWG

FRANK EDWARD SAILER JR. REGISTERED No. 21453 STATE OF INDIANA PROFESSIONAL ENGINEER

RECOMMENDED FOR APPROVAL Frank E. Sailer Jr. 2-5-97
DESIGN ENGINEER DATE

DESIGNED: SLO DRAWN: SLO

CHECKED: FES CHECKED: FES

INDIANA DEPARTMENT OF TRANSPORTATION

DETOUR DETAILS

HORIZONTAL SCALE	BRIDGE FILE
NO SCALE	8-75-4883B
VERTICAL SCALE	DESIGNATION
NO SCALE	8916700
SURVEY BOOK	SHEETS
N/A	2 of 20
CONTRACT	PROJECT
B-23076	STP/4075( )

LEGEND

Type "B" Construction Warning Lights

(**) Indicates Signs To Be Paid For As "Road Closure Sign Assembly".

ESTIMATE OF QUANTITIES

ITEM	UNIT	TOTAL
Maintaining Traffic	LSum	1
Construction Sign Type A	Each	18
Construction Sign Type B	Each	2
Detour Route Marker Assembly	Each	37
Standard Barricade Type III-A	Each	6
Standard Barricade Type III-B	Each	4
Road Closure Sign Assembly	Each	6
Line, Paint, Solid, White, 102 mm	Meter	454
Line, Paint, Broken, Yellow, 102 mm	Meter	57
Line, Paint, Solid, Yellow, 102 mm	Meter	114

Ⓑ ROAD CLOSED AHEAD — XW20-3, 1200 x 1200

Ⓒ DETOUR AHEAD — XW20-2, 1200 x 1200

Ⓖ ROAD CLOSED (**) — R11-2, 1200 x 750

Ⓘ ROAD CLOSED 1000 FT. — XW20-3, 1200 x 1200

Ⓕ ROAD CLOSED _ MILES AHEAD LOCAL TRAFFIC ONLY (**) — R11-3, 1500 x 750

DETOUR — XM4-10(R OR L), 1200 x 450

Ⓗ ROAD CLOSED 500 FT. — XW20-3, 1200 x 1200

Ⓙ ROAD CLOSED _ MILES AHEAD LOCAL TRAFFIC ONLY (**) — R11-3, 1500 x 750

NOTE:
2-LANE CLOSURE NOTICE SIGNS XG20-5 REQUIRED TO BE PLACED AS DIRECTED BY THE ENGINEER

DETOUR ROUTE MARKER ASSEMBLIES *

① DETOUR / WEST / INDIANA 8 / ↑	XM4-8 600 x 300; M3-4(S) 600 x 300; M1-I6 600 x 600; M6-3(S) 525 x 375	② DETOUR / WEST / INDIANA 8 / ↱	XM4-8 600 x 300; M3-4(S) 600 x 300; M1-I6 600 x 600; M5-1(R)(S) 525 x 375	③ DETOUR / WEST / INDIANA 8 / →	XM4-8 600 x 300; M3-4(S) 600 x 300; M1-I6 600 x 600; M6-1(S) 525 x 375	④ DETOUR / WEST / INDIANA 8 / ←	XM4-8 600 x 300; M3-4(S) 600 x 300; M1-I6 600 x 600; M6-1(S) 525 x 375
⑤ DETOUR / EAST / INDIANA 8 / ↰	XM4-8 600 x 300; M3-2(S) 600 x 300; M1-I6 600 x 600; M5-1(L)(S) 525 x 375	⑥ DETOUR / EAST / INDIANA 8 / ←	XM4-8 600 x300; M3-2(S) 600 x 300; M1-I6 600 x 600; M6-1(S) 525 x 375	⑦ DETOUR / WEST / INDIANA 8 / ↰	XM4-8 600 x 300; M3-4(S) 600 x 300; M1-I6 600 x 600; M5-1(L)(S) 525 x 375	⑧ DETOUR / EAST / INDIANA 8 / →	XM4-8 600 x 300; M3-2(S) 600 x 300; M1-I6 600 x 600; M6-1(S) 525 x 375
⑨ DETOUR / EAST / INDIANA 8 / ↑	XM4-8 600 x 300; M3-2(S) 600 x 300; M1-I6 600 x 600; M6-3(S) 525 x 375	⑩ DETOUR / EAST / INDIANA 8 / ↱	XM4-8 600 x 300; M3-2(S) 600 x 300; M1-I6 600 x 600; M5-1(R)(S) 525 x 375	⑪ END DETOUR / WEST / INDIANA 8	XM4-8a 600 x 450; M3-4(S) 600 x 300; M1-16 600 x 600	⑫ END DETOUR / EAST / INDIANA 8	XM4-8a 600 x 450; M3-2(S) 600 x 300; M1-I6 600 x 600
⑬ DETOUR / EAST / INDIANA 8 / ↱	XM4-8 600 x 300; M3-2(S) 600 x 300; M1-I6 600 x 600; M5-2(R)(S) 525 x 375	⑭ DETOUR / EAST / INDIANA 8 / ↗	XM4-8 600 x 300; M3-2(S) 600 x 300; M1-I6 600 x 600; M6-2(R)(S) 525 x 375	⑮ DETOUR / WEST / INDIANA 8 / ↱	XM4-8 600 x 300; M3-4(S) 600 x 300; M1-I6 600 x 600; M5-2(R)(S) 525 x 375	⑯ DETOUR / WEST / INDIANA 8 / ↗	XM4-8 600 x 300; M3-4(S) 600 x 300; M1-I6 600 x 600; M6-2(R)(S) 525 x 375

* TO BE PAID FOR AS "DETOUR ROUTE MARKER ASSEMBLY", EACH.

NOTE:
All Dimensions For Sign Sizes Shown In Millimeters.

Drwg. File: 9523TM2.DWG

FRANK EDWARD SAILER JR. REGISTERED No. 21453 STATE INDIANA PROFESSIONAL ENGINEER


RECOMMENDED FOR APPROVAL Frank E Sailer Jr. 2-5-97
DESIGN ENGINEER DATE

DESIGNED: SLO DRAWN: SLO
CHECKED: FES CHECKED: FES

INDIANA DEPARTMENT OF TRANSPORTATION

DETOUR DETAILS


HORIZONTAL SCALE	BRIDGE FILE
NO SCALE	8-75-4883B
VERTICAL SCALE	DESIGNATION
NO SCALE	8916700
SURVEY BOOK	SHEETS
N/A	3 of 20
CONTRACT	PROJECT
B-23076	STP/4075( )

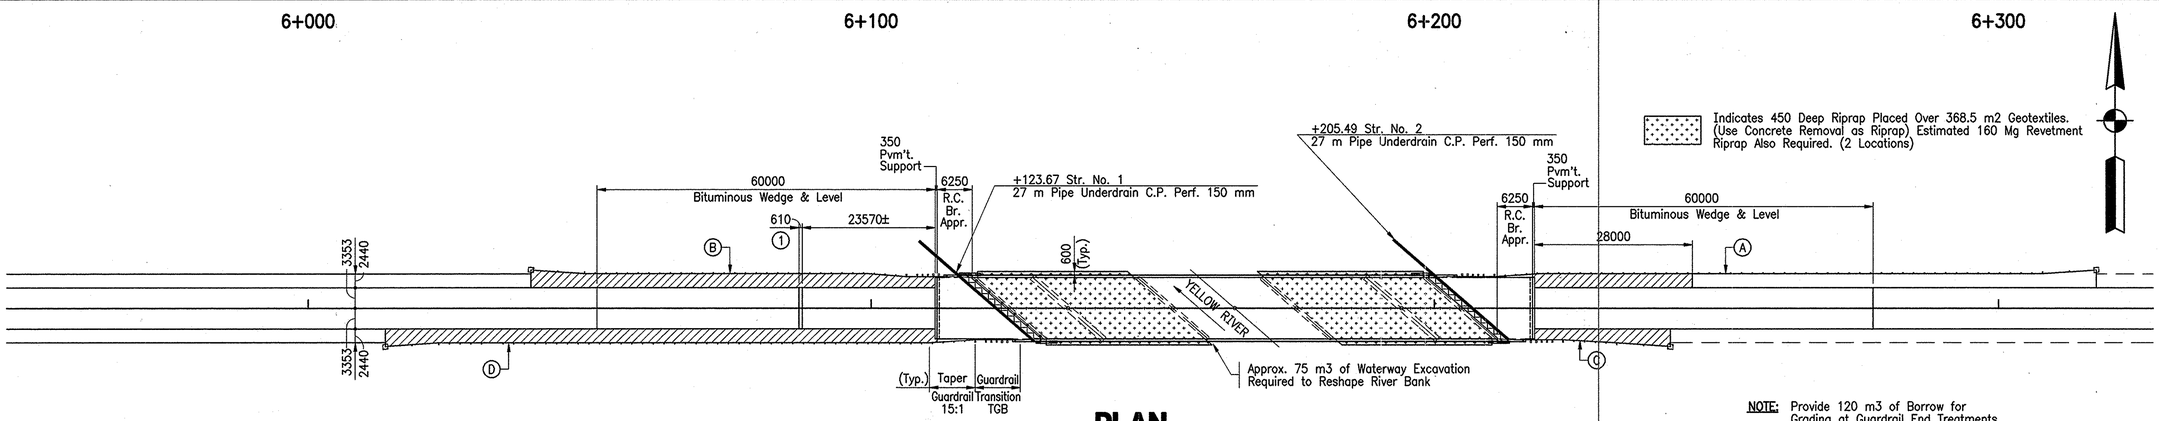

PLAN


Scale: 1:500

NOTE: Provide 120 m3 of Borrow for Grading at Guardrail End Treatments. (Bench as Directed)

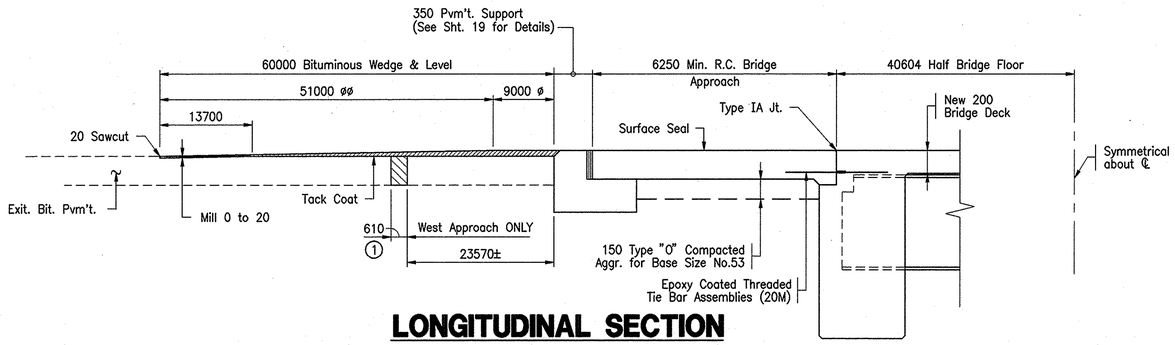

LONGITUDINAL SECTION


Not To Scale

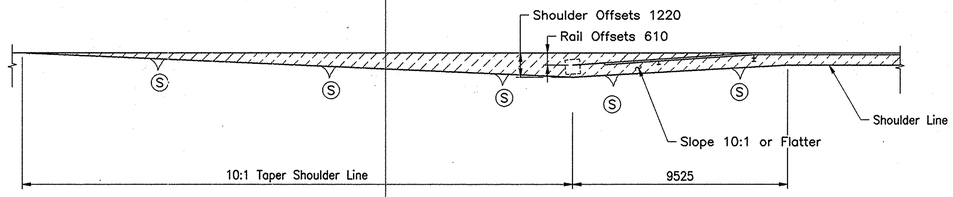

Ⓢ 2:1 Slope

GUARDRAIL END TREATMENT DETAIL

NO SCALE

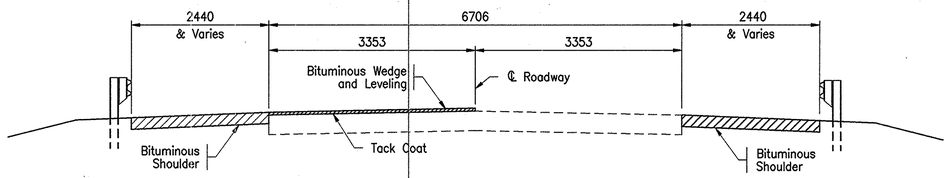

HALF SECTION INSIDE WEDGE & LEVELING HALF SECTION OUTSIDE WEDGE & LEVELING

TYPICAL SECTION

NO SCALE

GUARDRAIL LEGEND

	1	EA.	Guardrail, Transition, Type TGB
Ⓐ	97.16	m	Guardrail, W-Beam, Long Post, 1905 Spacing
	1	EA.	Guardrail, End Treatment, Type I
	45.11	m	Removal of Guardrail
	1	EA.	Guardrail, Transition, Type TGB
Ⓑ	57.15	m	Guardrail, W-Beam, Long Post, 1905 Spacing
	1	EA.	Guardrail, End Treatment, Type I
	45.11	m	Removal of Guardrail
	1	EA.	Guardrail, Transition, Type TGB
Ⓒ	9.50	m	Guardrail, W-Beam, Long Post, 1905 Spacing
	1	EA.	Guardrail, End Treatment, Type I
	45.11	m	Removal of Guardrail
	1	EA.	Guardrail, Transition, Type TGB
Ⓓ	95.25	m	Guardrail, W-Beam, Long Post, 1905 Spacing
	1	EA.	Guardrail, End Treatment, Type I
	45.11	m	Removal of Guardrail

GUARDRAIL SUMMARY

4	EA.	Guardrail, Transition, Type TGB
259.06	m	Guardrail, W-Beam, Long Post, 1905 Spacing
4	EA.	Guardrail, End Treatment, Type I
180.44	m	Removal of Guardrail

BITUMINOUS MIXTURE FOR APPROACHES, LV

BITUMINOUS PAVEMENT	2.2 Mg
BITUMINOUS WEDGE AND LEVEL	116.4 Mg
BITUMINOUS SHOULDER	196.5 Mg
	315.1 Mg

MATERIAL NOTES

✱ BITUMINOUS WEDGE AND LEVELING
60 kg/m2 HAC Surface Type II, LV
OVER
Variable Depth Bituminous Binder, LV or Bituminous Base, LV

BITUMINOUS SHOULDER
360 kg/m2 Bituminous Base Type 5D, LV

BITUMINOUS PAVEMENT
540 kg/m2 Bituminous Base Type 5D, LV

✱ The Maximum Depth Of HAC Surface Type II, LV Shall Not Exceed 40. At All Locations Where Total Wedge Thickness Will Exceed 40, Bituminous Binder, LV Or Bituminous Base, LV Shall Be Placed As A First Course To Within 25 Of Finished Grade.

LEGEND

- Bituminous Pavement
- Bituminous Wedge and Level
- Bituminous Shoulder
- ø Surface to be a Continuation of Bridge Deck Profile
- øø Taper Wedge Uniformly to Meet Existing Roadway Surface
- ① Remove Existing Joint and Place Bituminous Pavement Under Bituminous Wedge and Leveling

NOTE

All Dimensions are in Millimeters, Unless Noted.
All Stations are in Meters, Unless Noted.

FRANK EDWARD SAILER JR. REGISTERED No. 21453 STATE OF INDIANA PROFESSIONAL ENGINEER

RECOMMENDED FOR APPROVAL Frank E. Sailer Jr. 2-5-97
DESIGN ENGINEER DATE

DESIGNED: FES DRAWN: MBW
CHECKED: MJM CHECKED: FES


INDIANA DEPARTMENT OF TRANSPORTATION

LAYOUT

HORIZONTAL SCALE	BRIDGE FILE
AS NOTED	8-75-4883B
VERTICAL SCALE	DESIGNATION
AS NOTED	8916700
SURVEY BOOK	SHEETS
	4 of 20
CONTRACT	PROJECT
B-23076	STP-4075( )

Drwg. File: 9523LAY1

STRUCTURE TO BE BUILT TO A 152400 VERTICAL CURVE

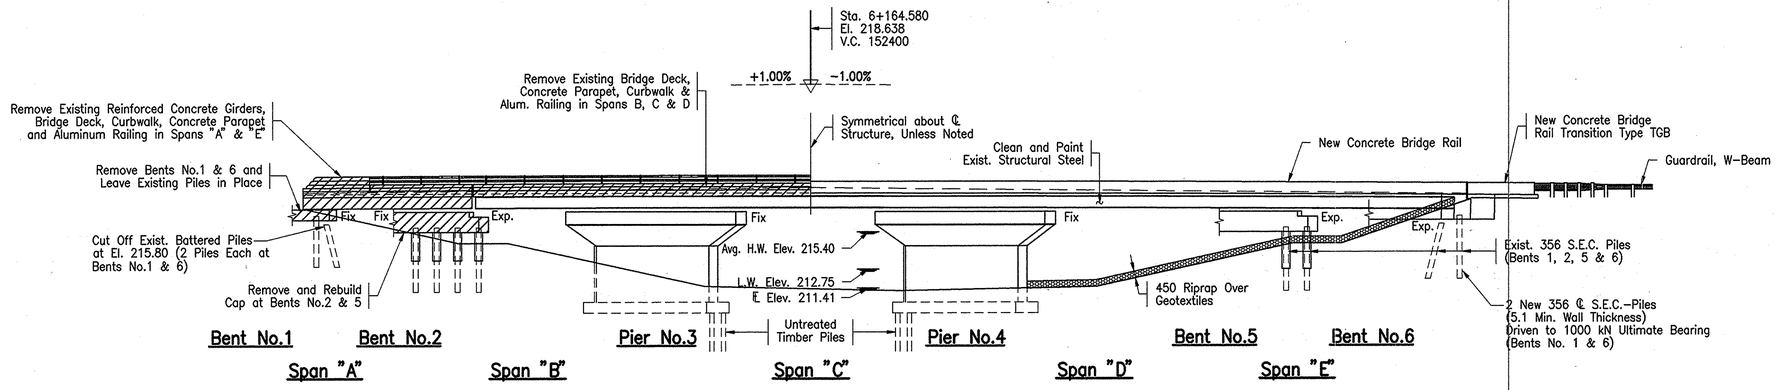


HALF ELEVATION SHOWING REMOVALS

HALF ELEVATION SHOWING RECONSTRUCTION

ELEVATION

Scale: 1:200

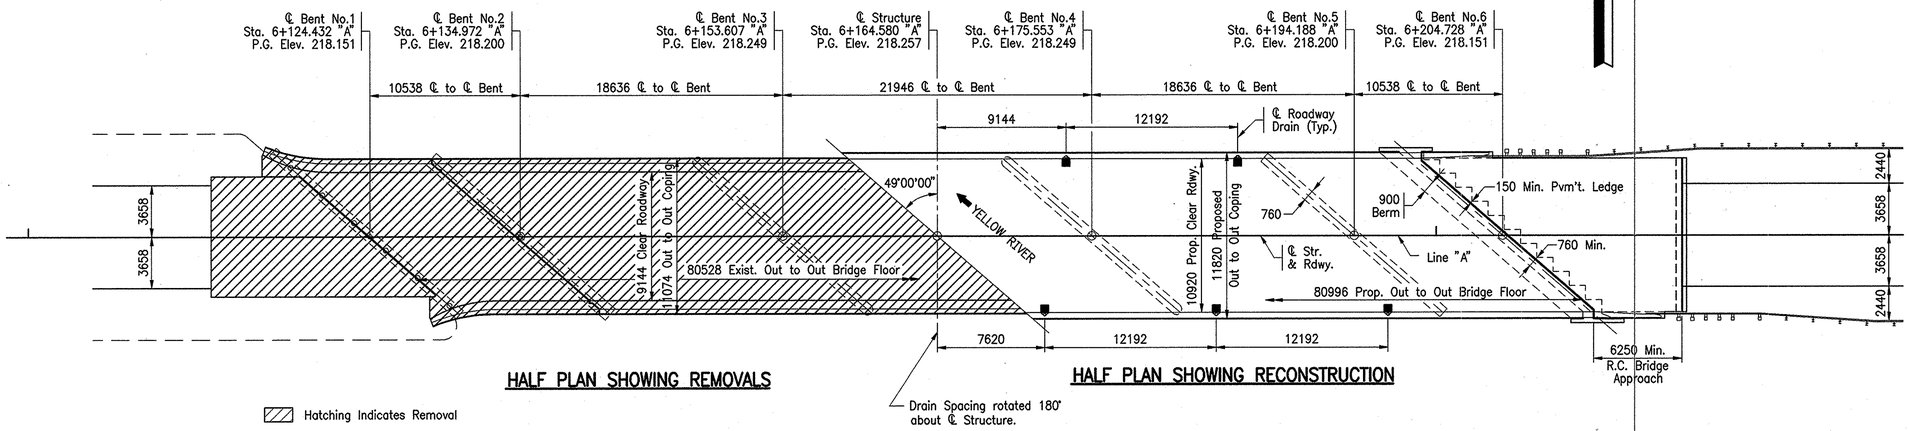

HALF PLAN SHOWING REMOVALS

HALF PLAN SHOWING RECONSTRUCTION

Hatching Indicates Removal

PLAN

Scale: 1:200

Drwg. File: 9523GP1

CONTINUOUS STEEL BEAM BRIDGE

5 SPANS: 10538, 18636, 21946, 18636, 10538
SKEW: 49° LEFT; 10920 PROPOSED CLEAR ROADWAY
S.R. 8 OVER YELLOW RIVER

STARKE COUNTY

FRANK EDWARD SAUER JR. REGISTERED No. 21453 STATE OF INDIANA PROFESSIONAL ENGINEER


RECOMMENDED FOR APPROVAL Frank E. Sauer Jr. 2-5-97
DESIGN ENGINEER DATE

DESIGNED: FES DRAWN: MBW
CHECKED: MJM CHECKED: MJM

INDIANA DEPARTMENT OF TRANSPORTATION

GENERAL PLAN

HORIZONTAL SCALE	BRIDGE FILE
AS NOTED	8-75-4883B
VERTICAL SCALE	DESIGNATION
AS NOTED	8916700
SURVEY BOOK	SHEETS
	5 of 20
CONTRACT	PROJECT
B-23076	STP-4075( )

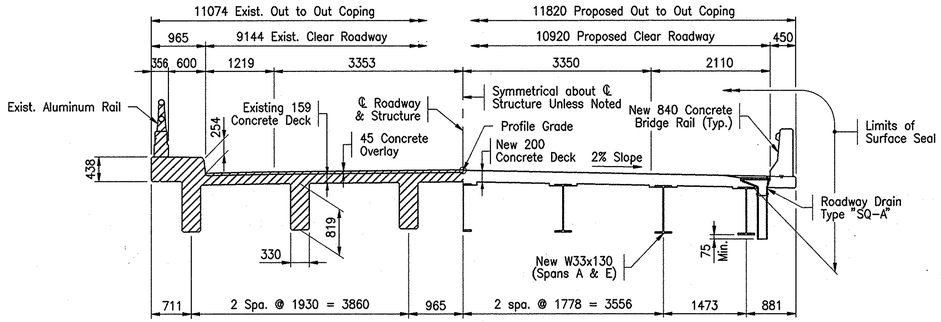

HALF SECTION SHOWING REMOVAL HALF SECTION SHOWING RECONSTRUCTION

TYPICAL SECTION SPANS A & E

Scale: 1:50

GENERAL NOTES

HALF SECTION SHOWING REMOVAL HALF SECTION SHOWING RECONSTRUCTION

TYPICAL SECTION SPANS B, C & D

Scale: 1:50

GENERAL NOTES

Plans for the existing structure are on file in the Central Office as Bridge File 8-75-4883 and 8-75-4883A and are available upon request.

Chamfer exposed edges 25 unless noted.

Concrete in Bridge Rail and Deck to be Class "C".

Concrete in Mudwall, End Bents, Bent Caps and Crashwalls to be Class "A".

Reinforcing cover shall be 50 unless noted.

All bituminous material required in this contract to be included in the pay item "Bituminous Mixture For Approaches, LV", except Tack Coat which shall be paid for separately.

All Surface Seal to be paid for as Lump Sum.

Clean and seal all concrete area from exterior beam flange to exterior beam flange (includes bridge railing and copings) as shown on the plans.

Clean and seal exposed faces of Wingwalls.

Surface Seal on vertical surfaces to be in accordance with Article 709.05.

Clean and seal top of R. C. Bridge Approaches.

Estimated Quantity of Surface Seal = 1673.8 m2.

Remove and reset roadway and bridge reference signs.

All existing structural steel to be painted, paint shall be in accordance with current INDOT Specifications

First Field Coat: Inorganic Zinc Primer
Second Field Coat: Waterborne or Vinyl Finish Coat
Existing Paint: Lead

Estimated weight of Structural Steel to be painted = 94 Mg

JACKING LOADS EACH BEAM

(Beam Dead Load Only of Existing 3-Span Beams)

Pier No. 2 = 25 kN
Pier No. 5 = 25 kN

DESIGN DATA

Allowable Design Stresses:

Class "C" Concrete	f'c = 27 MPa
Class "A" Concrete	f'c = 24 MPa
Class "B" Concrete	f'c = 21 MPa
Reinforcing Steel (Grade 60)	fy = 410 MPa

Drwg. File: 95236P2

CONTINUOUS STEEL BEAM BRIDGE

5 SPANS: 10538, 18636, 21946, 18636, 10538
SKEW: 49° LEFT; 10920 PROPOSED CLEAR ROADWAY
S.R. 8 OVER YELLOW RIVER

STARKE COUNTY

FRANK EDWARD SAILER JR. REGISTERED No. 21453 STATE OF INDIANA PROFESSIONAL ENGINEER


RECOMMENDED FOR APPROVAL Frank E Sailer Jr. 2-5-97
DESIGN ENGINEER DATE

DESIGNED: FES DRAWN: MBW
CHECKED: MJM CHECKED: FES

INDIANA DEPARTMENT OF TRANSPORTATION


GENERAL PLAN


HORIZONTAL SCALE	BRIDGE FILE
AS NOTED	8-75-4883B
VERTICAL SCALE	DESIGNATION
AS NOTED	8916700
SURVEY BOOK	SHEETS
	6 of 20
CONTRACT	PROJECT
B-23076	STP-4075( )

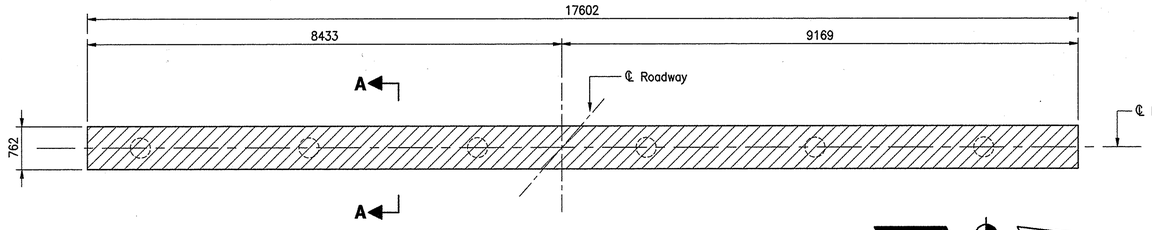

BENT NO. 1 OR NO. 6 - REMOVALS


SCALE: 1:20

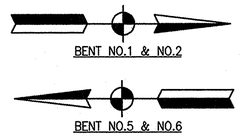

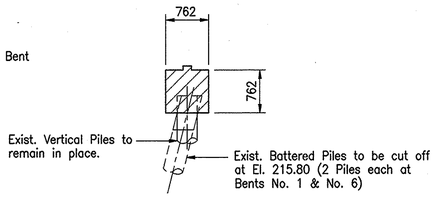


SECTION A-A

SCALE: 1:20

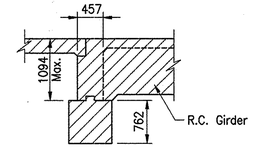

SECTION C-C


SCALE: 1:20

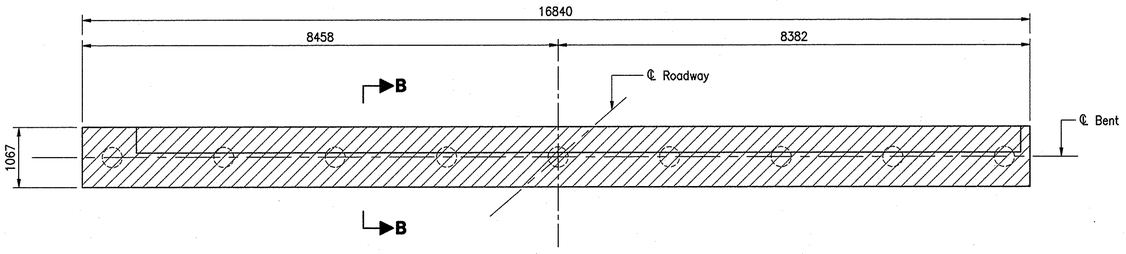

BENT NO. 2 OR NO. 5 - REMOVALS


SCALE: 1:20

Hatching indicates removal

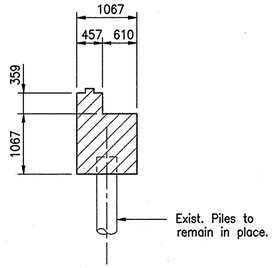


SECTION B-B

SCALE: 1:20

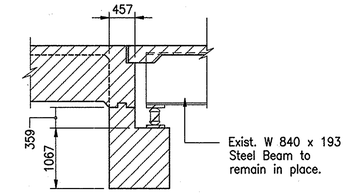

SECTION D-D

SCALE: 1:20

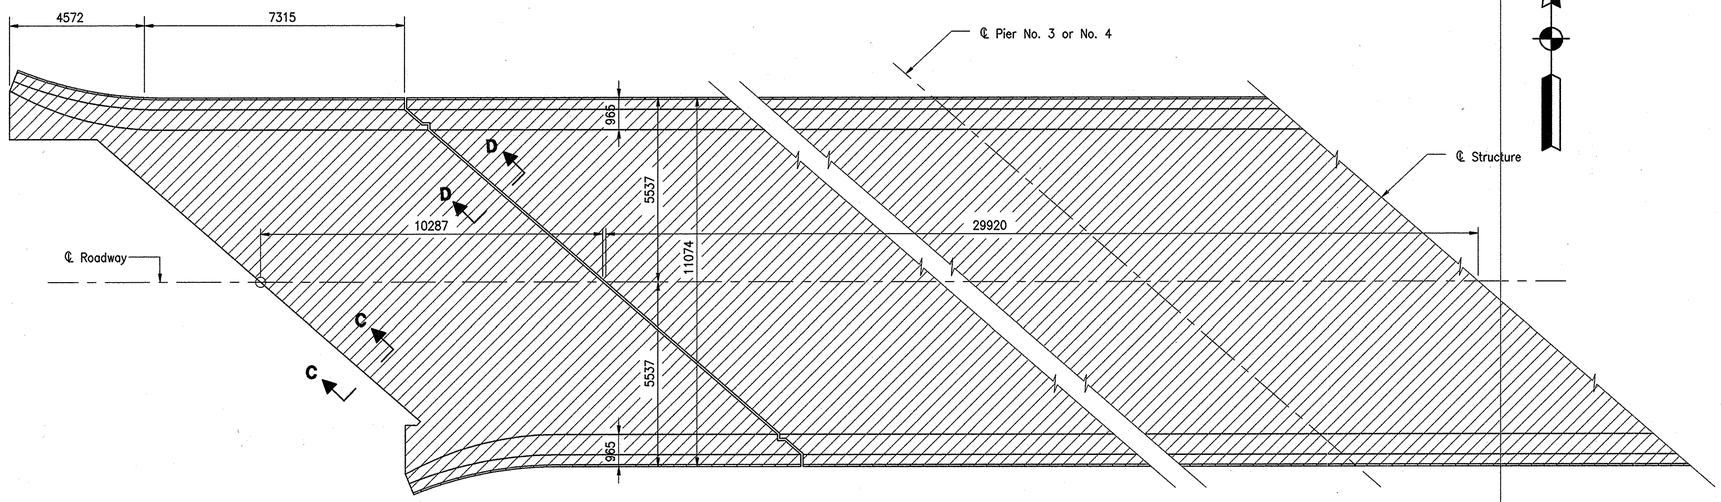

SPAN "A" OR "E" | SPAN "B" OR "D" | HALF SPAN "C"

HALF FLOOR SLAB PLAN - REMOVALS

SCALE: 1:20

NOTES

All dimensions are in millimeters.

Drwg. File: 9523REM1

FRANK EDWARD SAILER JR. REGISTERED No. 21453 STATE OF INDIANA PROFESSIONAL ENGINEER


RECOMMENDED FOR APPROVAL Frank E. Sailer Jr. 2-5-97
DESIGN ENGINEER DATE

DESIGNED: FES | DRAWN: TLH
CHECKED: MJM | CHECKED: FES

INDIANA DEPARTMENT OF TRANSPORTATION

REMOVAL DETAILS


HORIZONTAL SCALE	BRIDGE FILE
AS NOTED	8-75-4883B
VERTICAL SCALE	DESIGNATION
AS NOTED	8916700
SURVEY BOOK	SHEETS
	7 of 20
CONTRACT	PROJECT
B-23076	STP-4075( )

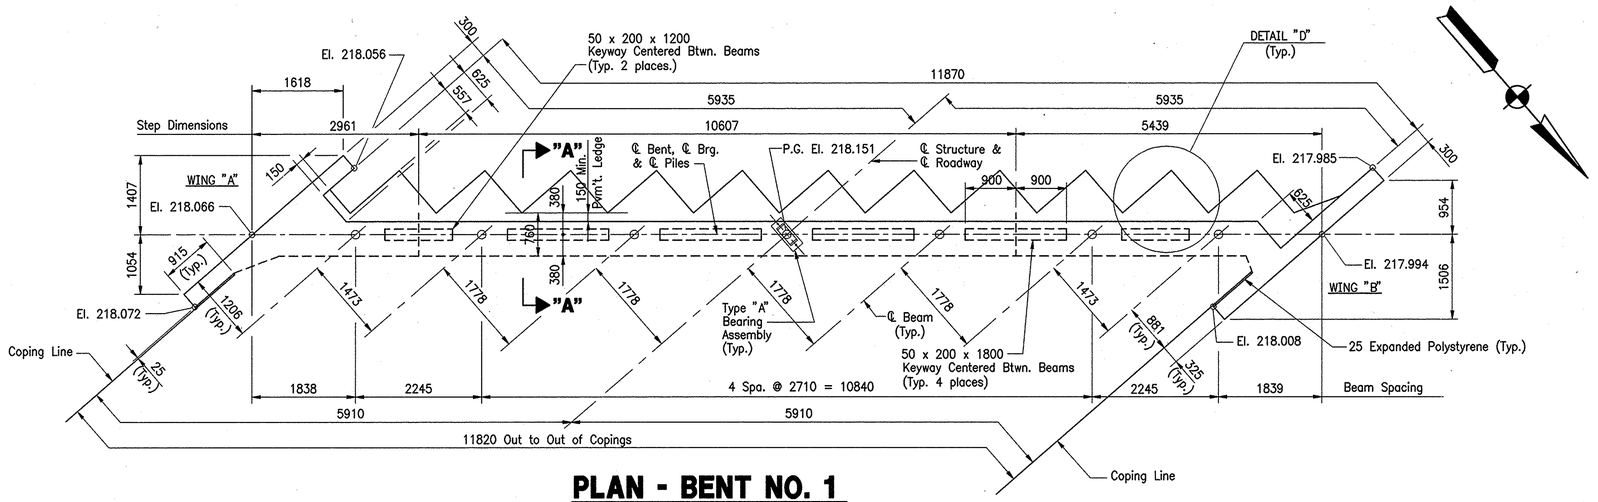

PLAN - BENT NO. 1
BENT NO. 6 SAME BY 180 ROTATION


SCALE: 1:50

NOTE:
Concrete Bridge Rail not shown for clarity.

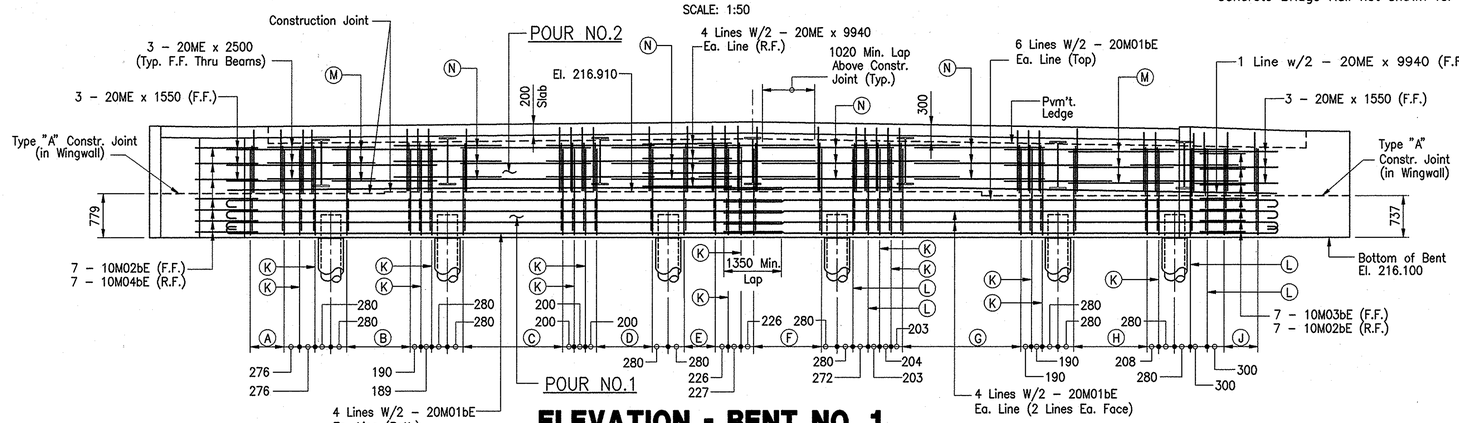

ELEVATION - BENT NO. 1
BENT NO. 6 SAME BY 180 ROTATION

SCALE: 1:50

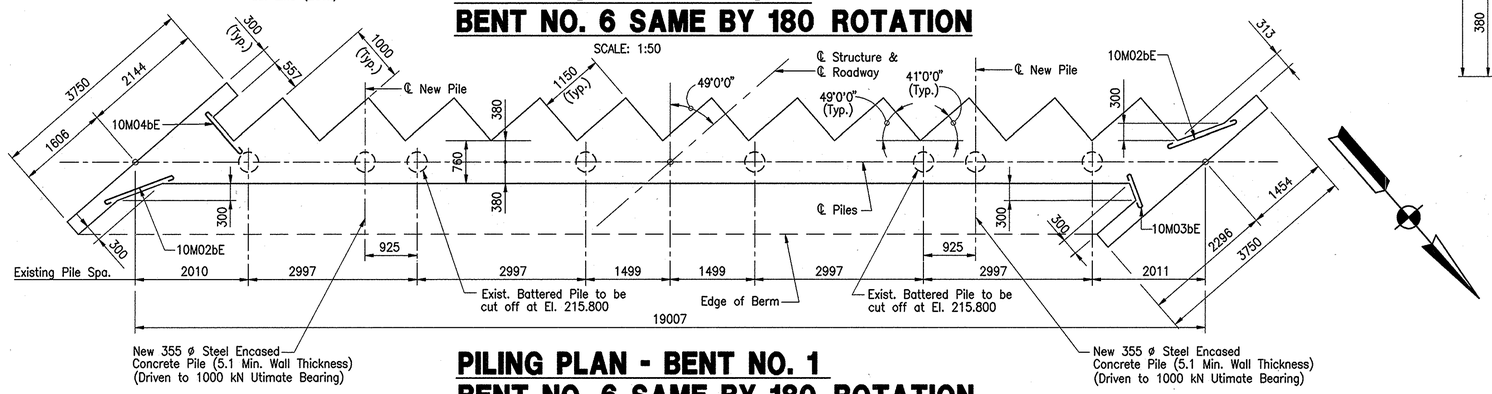


PILING PLAN - BENT NO. 1
BENT NO. 6 SAME BY 180 ROTATION

SCALE: 1:50

LEGEND

- (A) 2 spa. @ 300 max. = 600
  3–20M02bE, 3–20M04bE, 3–20M05bE, 9–10M01bE & 3–20M06bEE
- (B) 4 eq. spa. @ 300 max. = 1133
  5–20M02bE, 5–20M04bE, 5–20M05bE, 15–10M01bE & 5–20M06bE
- (C) 6 eq. spa. @ 300 max. = 1771
  7–20M02bE, 7–20M04bE, 7–20M05bE, 21–10M01bE & 7–20M06bE
- (D) 4 eq. spa. @ 300 max. = 991
  5–20M02bE, 5–20M04bE, 5–20M05bE, 15–10M01bE & 5–20M06bE
- (E) 3 eq. spa. @ 300 max. = 559
  4–20M02bE, 4–20M04bE, 4–20M05bE, 12–10M01bE & 4–20M06bE
- (F) 4 spa. @ 300 max. = 1200
  5–20M02bE, 5–20M04bE, 5–20M05bE, 15–10M01bE & 5–20M06bE
- (G) 7 spa. @ 300 max. = 2100
  8–20M02bE, 8–20M04bE, 8–20M05bE, 24–10M01bE & 8–20M06bE
- (H) 5 eq. spa. @ 300 max. = 1304
  6–20M02bE, 6–20M04bE, 6–20M05bE, 18–10M01bE & 6–20M06bE
- (J) 2 spa. @ 300 max. = 600
  3–20M02bE, 3–20M04bE, 3–20M05bE & 9–10M01bE
- (K) 1–20M03bE, 1–20M04bE, 3–10M01bE & 1–20M06bE
- (L) 1–20M02bE, 1–20M04bE, 1–20M05bE, 3–10M01bE & 1–20M06bE
- (M) 3 – 20ME x 1800 (F.F. Btwn. Beams) (Typ.)
- (N) 3 – 20ME x 2250 (F.F. Btwn. Beams) (Typ.)

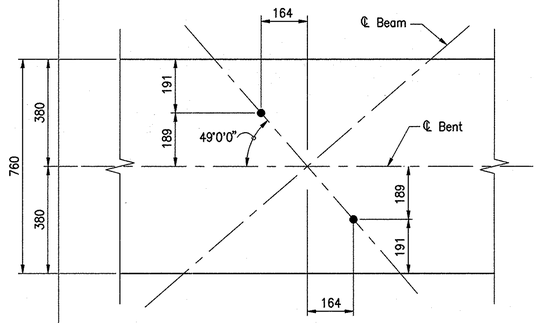

ANCHOR BOLT SETTING DIAGRAM

SCALE: 1:10

NOTES:

All Reinforcing to be Epoxy Coated.

All dimensions are in millimeters and all elevations are in meters unless noted.

For Reinforcing Bar Notes, See Br. Std. 703–BRST–01.

For Section "A–A", Detail "D", Bar Bending Details, Wingwall Details and Bill of Materials, See Sht. 9.

For Type "A" Construction Joint, See Br. Std. 724–BJTS–01.

Drwg. File: 9523SPR3

FRANK EDWARD SALER JR. REGISTERED No. 21453 STATE OF INDIANA PROFESSIONAL ENGINEER


RECOMMENDED FOR APPROVAL Frank E. Saler Jr. 2-5-97
DESIGN ENGINEER DATE

DESIGNED: MJM DRAWN: TLH
CHECKED: FES CHECKED: FES

INDIANA DEPARTMENT OF TRANSPORTATION


BENTS NO.1 AND NO.6 DETAILS

HORIZONTAL SCALE	BRIDGE FILE
AS NOTED	8–75–4883B
VERTICAL SCALE	DESIGNATION
AS NOTED	8916700
SURVEY BOOK	SHEETS
	8 of 20
CONTRACT	PROJECT
B-23076	STP-4075( )

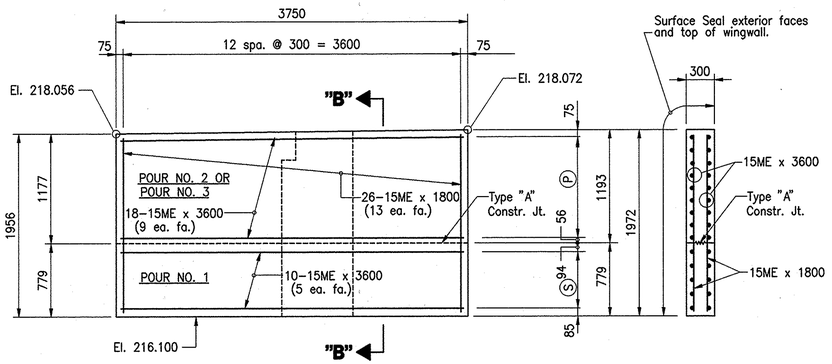


WING 'A' - ELEVATION

SCALE: 1:20

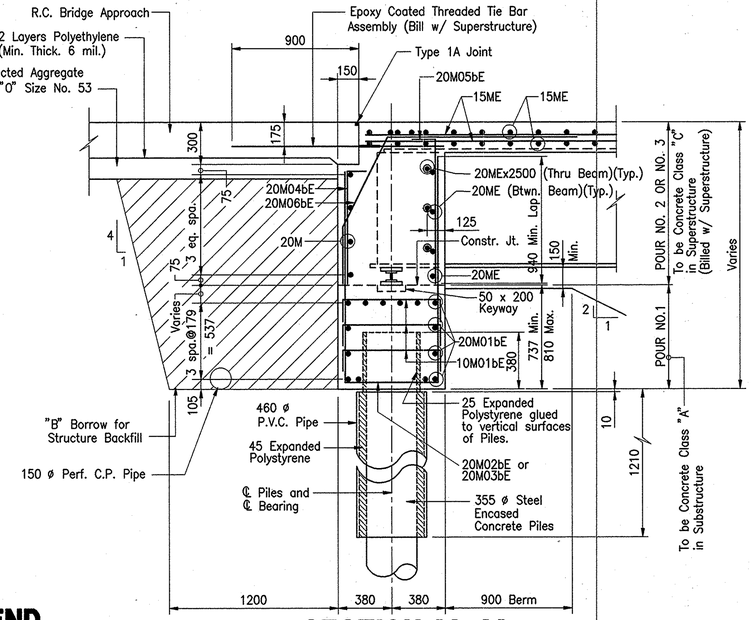

SECTION 'A-A'

SCALE: 1:20

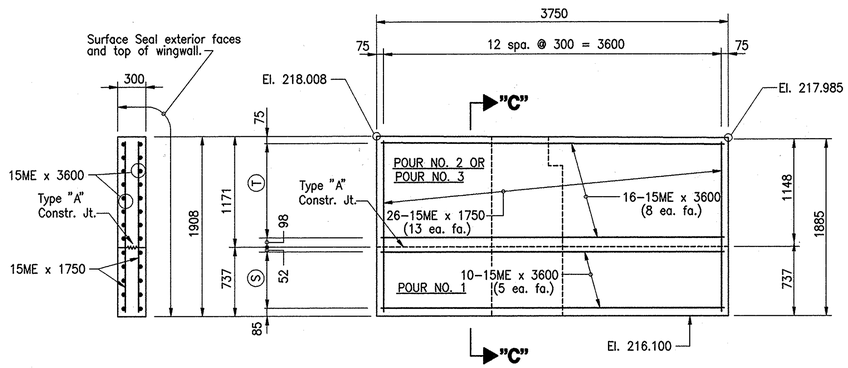

SECTION 'C-C'


SCALE: 1:20

LEGEND

Ⓟ 8 eq. spa. @ 150 max.


Ⓢ 4 spa. @ 150 = 600

Ⓣ 7 eq. spa. @ 150 max.

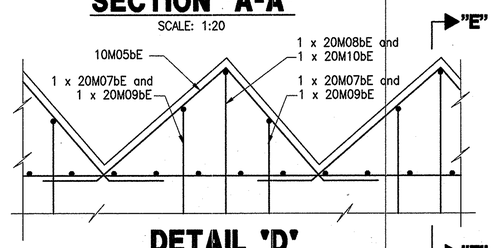


DETAIL 'D'

SCALE: 1:20

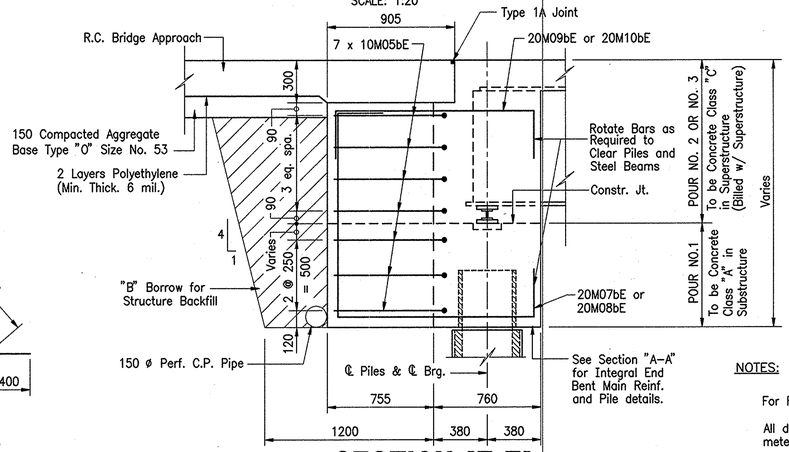

SECTION 'E-E'

SCALE: 1:20

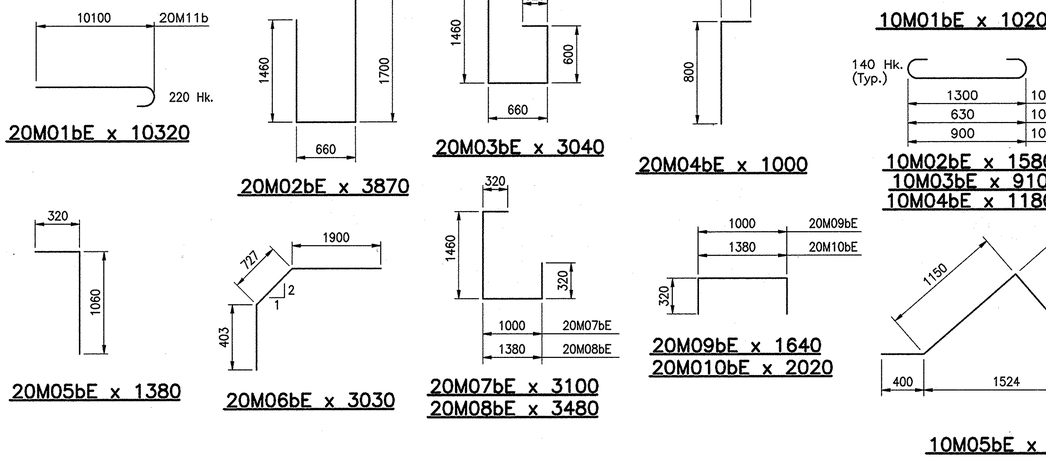

BILL OF MATERIALS FOR BENT NO.1

(BENT NO.6 SAME UNLESS NOTED)

EPOXY COATED REINFORCING STEEL			
SIZE OR MARK	NUMBER OF BARS	LENGTH (mm)	MASS (kg)
20M01bE	28	10320	
20M02bE	50	3870	
20M03bE	13	3040	
20M04bE	63	1000	
20M05bE	50	1380	
20M06bE	60	3030	
20M07bE	22	3100	
20M08bE	11	3480	
20M09bE	22	1640	
20M10bE	11	2020	
20ME	10	9940	
20ME	12	2250	
20ME	21	2500	
20ME	6	1800	
20ME	6	1550	
TOTAL 20M EPOXY COATED REINF.			2825
15ME	54	3600	
15ME	26	1800	
15ME	26	1750	
TOTAL 15M EPOXY COATED REINF.			451
10M01bE	189	1020	
10M02bE	14	1580	
10M03bE	7	910	
10M04bE	7	1180	
10M05bE	77	2950	
TOTAL 10M EPOXY COATED REINF.			359
TOTAL EPOXY COATED REINF.			3635
CONCRETE			
Class "A" Conc. in Pour No. 1			17.7 m3
TOTAL CONCRETE CLASS "A" IN SUBSTRUCTURE			17.7 m3
MISCELLANEOUS			
Surface Seal (Est. 19.1 m2)			LSUM
"B" Borrow for Structure Backfill			30.0 m3
Dry Excavation			84.0 m3
Pipe, P.V.C., 460 mm ø			7.2 m
BENT NO.1			
355 ø Steel Encased Concrete Pile Shells (2 @ 14 m)			28 m
BENT NO.6			
355 ø Steel Encased Concrete Pile Shells (2 @ 11 m)			22 m

NOTES:

For Reinforcing Bar Notes, see Br. Std. 703–BRST–01.

All dimensions are in millimeters and all elevations are in meters, unless noted.

For Type 1A Joint, See Bridge Std. 724–BJTS–01.

Drwg. File: 9523SPR4

FRANK EDWARD SAILER JR. REGISTERED No. 21453 STATE OF INDIANA PROFESSIONAL ENGINEER

RECOMMENDED FOR APPROVAL Frank E Sailer Jr. 2-5-97
DESIGN ENGINEER DATE


DESIGNED: MJM DRAWN: TLH

CHECKED: FES CHECKED: MJM/FES

INDIANA DEPARTMENT OF TRANSPORTATION

BENT NO.1 AND NO.6 DETAILS


HORIZONTAL SCALE	BRIDGE FILE
AS NOTED	8–75–4883B
VERTICAL SCALE	DESIGNATION
AS NOTED	8916700
SURVEY BOOK	SHEETS
	9 of 20
CONTRACT	PROJECT
B-23076	STP–4075( )

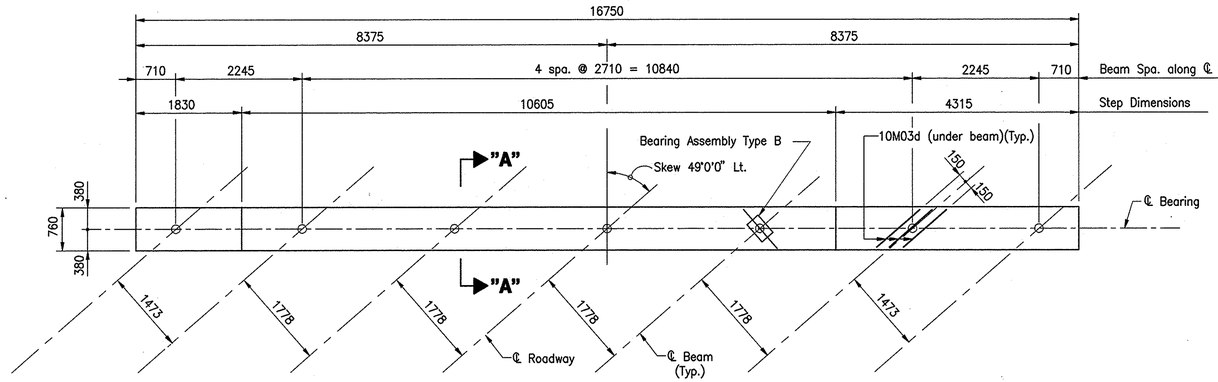

PLAN - BENT NO. 2


(BENT NO. 5 SAME BY 180° ROTATION)

SCALE: 1:50

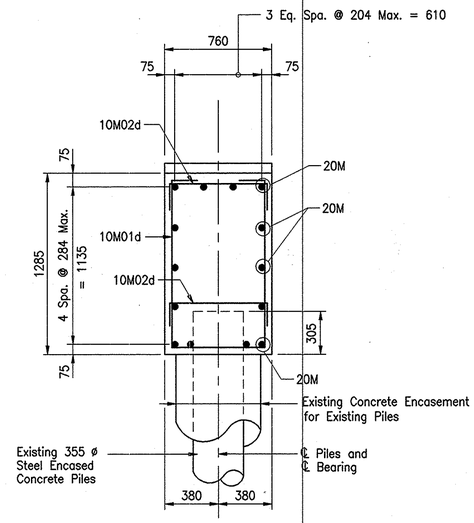

SECTION "A-A"

SCALE: 1:20

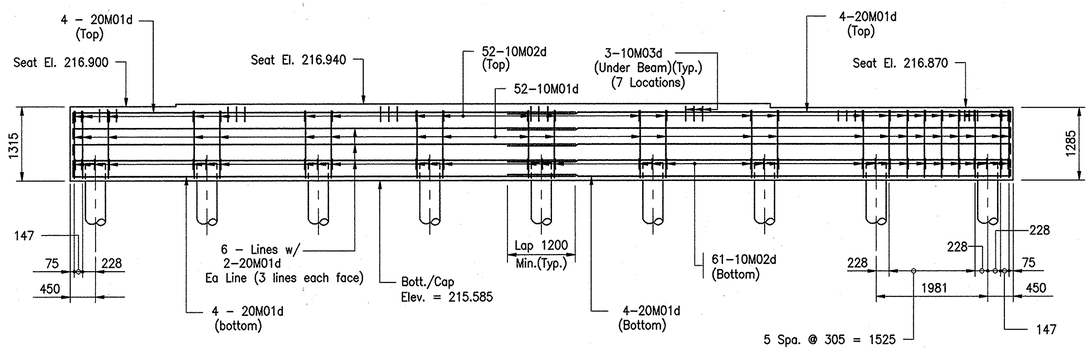


NOTE: CONCRETE ENCASEMENT OF EXISTING PILES NOT SHOWN.

ELEVATION - BENT NO. 2

(BENT NO. 5 SAME BY 180° ROTATION)

SCALE: 1:50

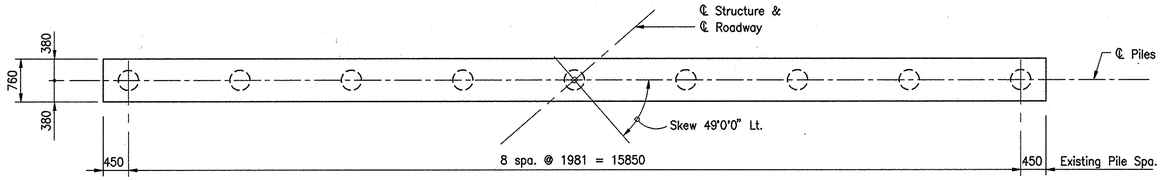

EXISTING PILING PLAN - BENT NO. 2


(BENT NO. 5 SAME BY 180° ROTATION)

SCALE: 1:50

BILL OF MATERIALS FOR BENT NO. 2

(BENT NO. 5 SAME)

REINFORCING STEEL			
SIZE OR MARK	NUMBER OF BARS	LENGTH (mm)	MASS (kg)
20M01d	28	9220	
TOTAL 20ME			608
10M01d	52	3390	
10M02d	113	1020	
10M03d	21	1500	
TOTAL 10ME			254
TOTAL EPOXY COATED REINFORCING			862
CONCRETE			
Class "A" Conc. in Substructure			17.0 m3

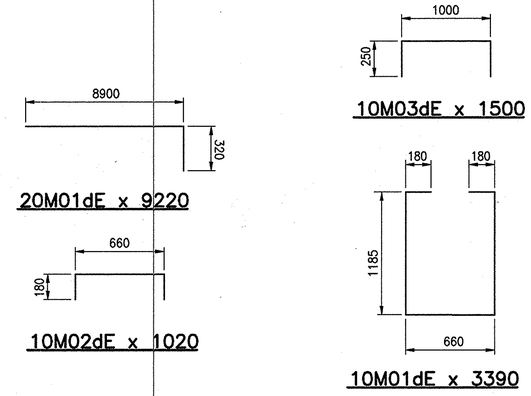

BAR BENDING DETAILS

NOT TO SCALE

NOTES:

All dimensions are in millimeters & all elevations are in meters unless noted.

For Reinforcing Bar Notes, See Br. Std. 703-BRST-01.

Drwg. File: 9523BNT2

FRANK EDWARD SAILER JR. REGISTERED No. 21453 STATE OF INDIANA PROFESSIONAL ENGINEER


RECOMMENDED FOR APPROVAL Frank E. Sailer Jr. 2-5-97
DESIGN ENGINEER DATE

DESIGNED: MJM DRAWN: TLH
CHECKED: FES CHECKED: FES

INDIANA DEPARTMENT OF TRANSPORTATION

BENTS NO.2 AND NO.5 DETAILS


HORIZONTAL SCALE	BRIDGE FILE
AS NOTED	8-75-4883B
VERTICAL SCALE	DESIGNATION
AS NOTED	8916700
SURVEY BOOK	SHEETS
	10 of 20
CONTRACT	PROJECT
B-23076	STP-4075( )

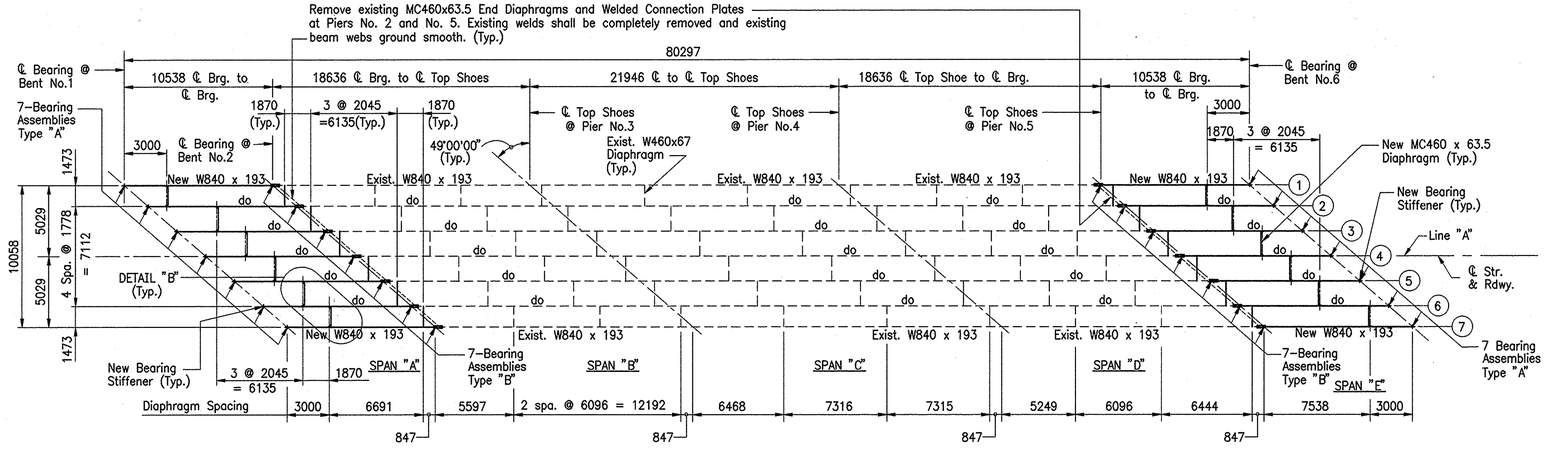

FRAMING PLAN

SCALE: 1:200

NOTE: CLEAN AND PAINT ALL EXISTING STRUCTURAL STEEL.

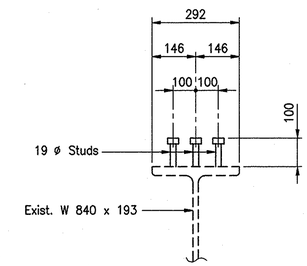

TYPICAL SHEAR CONNECTION DETAIL

NOT TO SCALE


T = Tension
C = Compression

3763	4697	2078	1906	2500	7346	4092	2792	2704	3050	5219
C	T/C	T	T	T/C	C	T/C	T	T	T/C	C

10538 — SPAN "A" OR "E"
18636 — SPAN "B" OR "D"
10973 — HALF SPAN "C"

TENSION/COMPRESSION DIAGRAM NEW AND EXISTING BEAMS

NOT TO SCALE

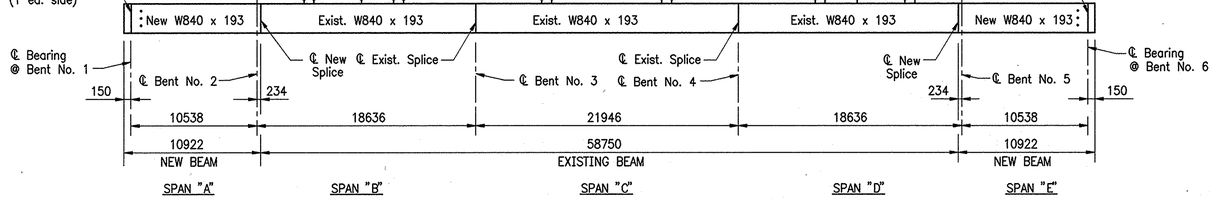


NEW AND EXISTING BEAM ELEVATION

NOT TO SCALE


SHIM TABLE

LOCATION	BENT NO.1	PIER NO.2	BENT NO.5	BENT NO.6
Beam #1	11	14	30	30
Beam #2	50	50	12	20
Beam #3	11	11	28	32
Beam #4	35	32	32	35
Beam #5	32	28	11	11
Beam #6	20	12	50	50
Beam #7	30	30	14	11

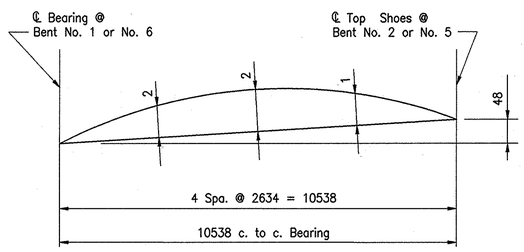

NO LOAD CAMBER DIAGRAM NEW BEAMS

NOT TO SCALE

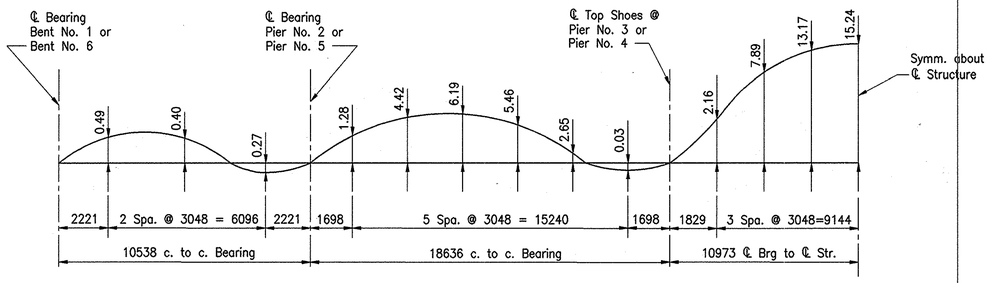

CONCRETE DEAD LOAD DEFLECTION DIAGRAM

NOT TO SCALE

NOTES:

For Additional Details, See Sht. 12 and Sht. 13.

All Structural Steel to be A709-36.

Total Estimated Weight of Structural Steel = 35,867 Kg
Includes the Weight of Shear Connectors. Does not include Bolts, Anchor Bolts and Structural Steel for Bearing Assemblies.

See Sht. 12 for Detail "B".

Drwg. File: 9523STL1

FRANK EDWARD SAILER, JR. REGISTERED No. 21453 STATE OF INDIANA PROFESSIONAL ENGINEER


RECOMMENDED FOR APPROVAL Frank E. Sailer Jr. 2-5-97
DESIGN ENGINEER DATE

DESIGNED: FES DRAWN: TLH
CHECKED: MJM CHECKED: MJM

INDIANA DEPARTMENT OF TRANSPORTATION


STRUCTURAL STEEL DETAILS

HORIZONTAL SCALE	BRIDGE FILE
AS NOTED	8-75-4883B
VERTICAL SCALE	DESIGNATION
AS NOTED	8916700
SURVEY BOOK	SHEETS
	11 of 20
CONTRACT	PROJECT
B-23076	STP-4075( )

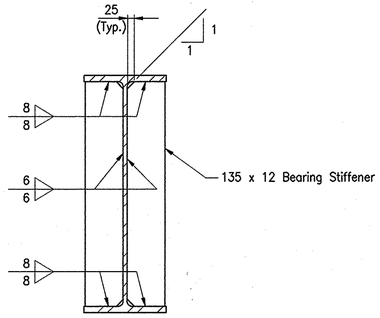


BEARING STIFFENER DETAIL

Scale: 1:10

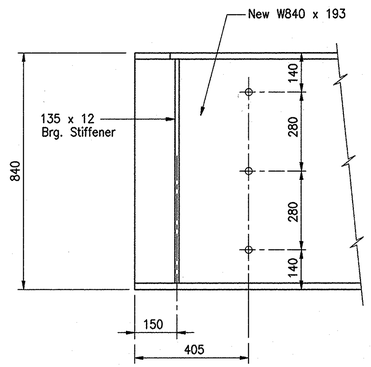

BEAM ELEVATION AT BENT NO.1 OR NO.6


Scale: 1:10

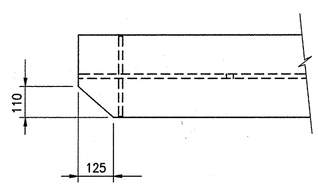


BENT NO.1 BENT NO.6

TOP FLANGE PLAN AT END OF BEAM AT BENT NO.1 OR NO.6

Scale: 1:10

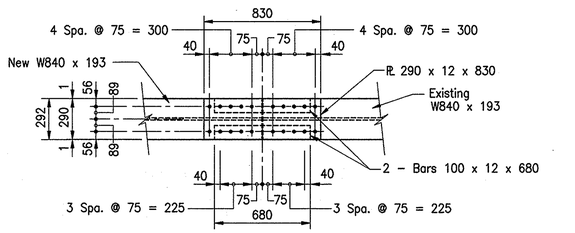


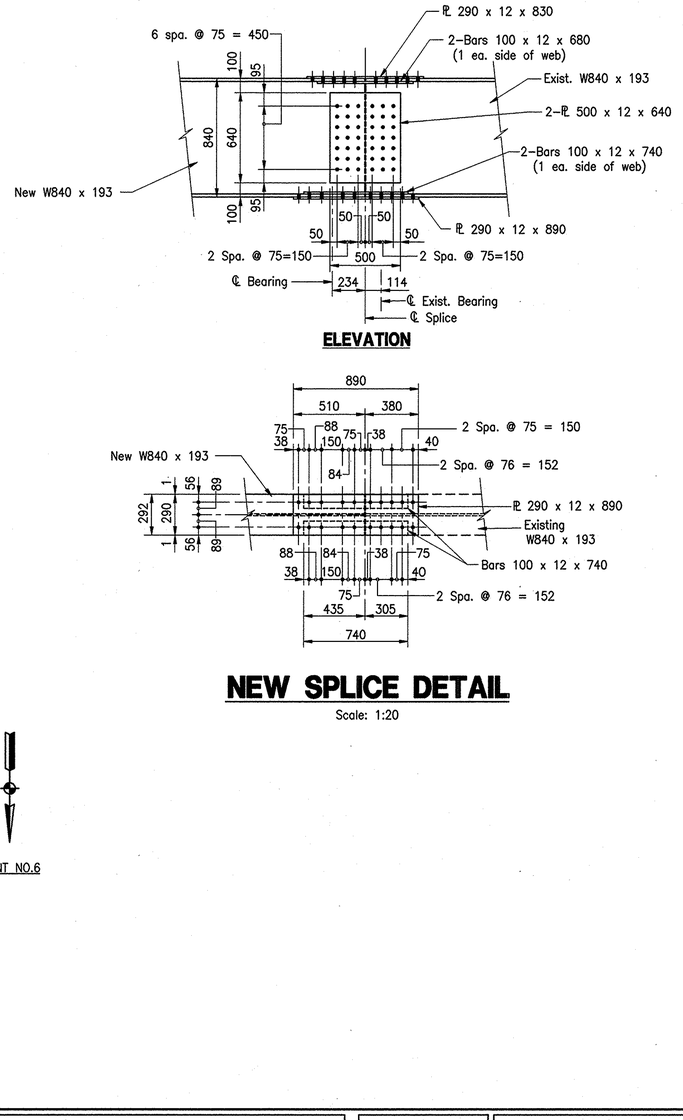


ELEVATION

NEW SPLICE DETAIL

Scale: 1:20

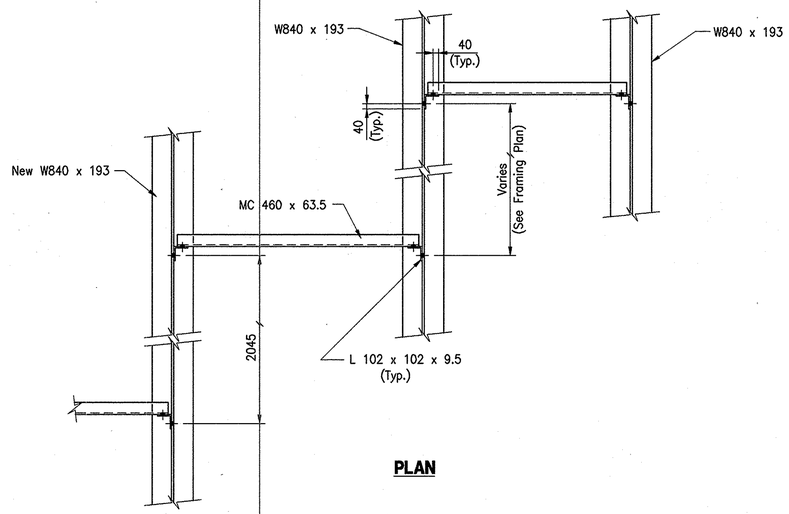

PLAN

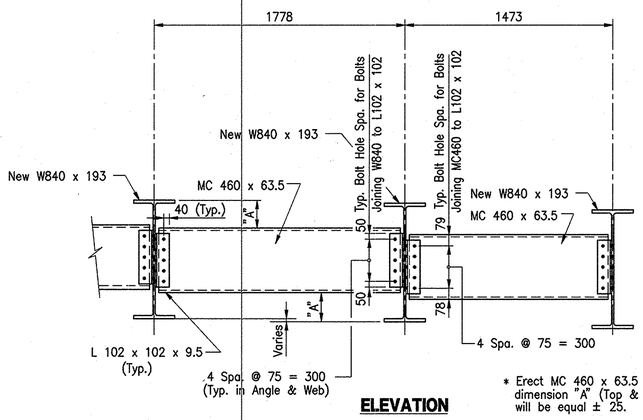

* Erect MC 460 x 63.5 so that dimension "A" (Top & Bott.) will be equal ± 25.

ELEVATION

DETAIL "B"

Scale: 1:20

NOTES:

All Structural Steel to be A709–36.

Drwg. File: 9523STL2

FRANK EDWARD SAILER, JR. REGISTERED No. 21453 STATE OF INDIANA PROFESSIONAL ENGINEER


RECOMMENDED FOR APPROVAL Frank E. Sailer Jr. 2-5-97
DESIGN ENGINEER DATE


DESIGNED: FES DRAWN: TLH
CHECKED: MJM CHECKED: MJM


INDIANA DEPARTMENT OF TRANSPORTATION

STRUCTURAL STEEL DETAILS

HORIZONTAL SCALE	BRIDGE FILE
AS NOTED	8-75-4883B
VERTICAL SCALE	DESIGNATION
AS NOTED	8916700
SURVEY BOOK	SHEETS
	12 of 20
CONTRACT	PROJECT
B-23076	STP-4075( )

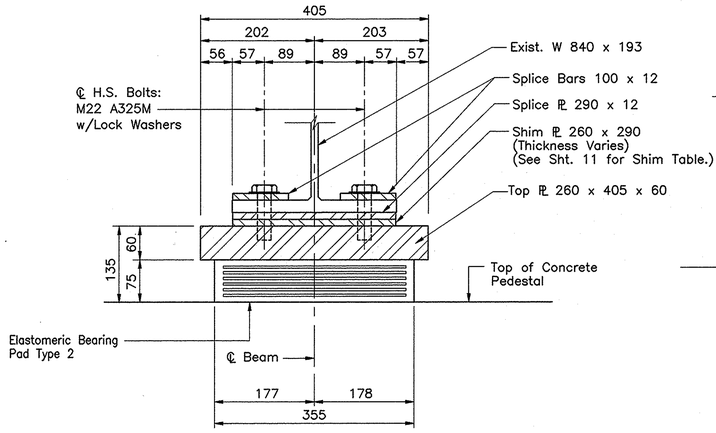


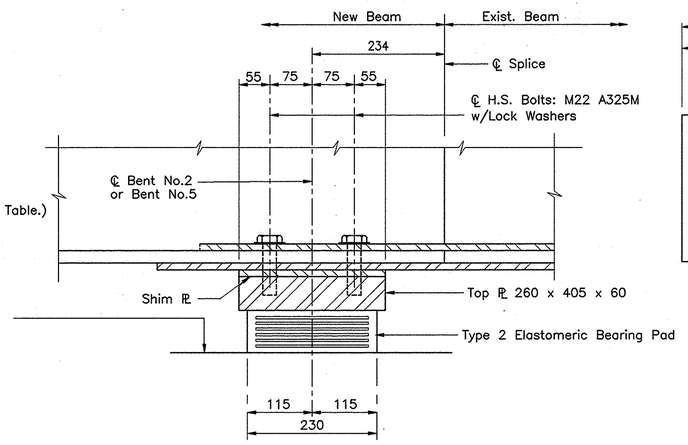

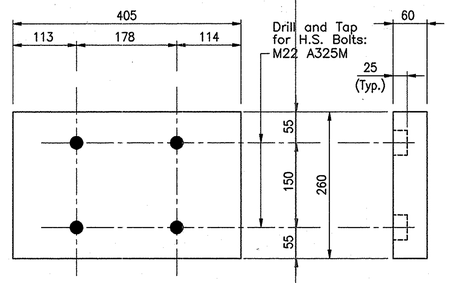

TOP PLATE

SCALE: 1:5

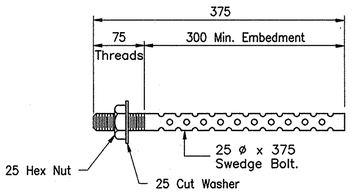



ANCHOR BOLT DETAIL


NOT TO SCALE

BEARING ASSEMBLY TYPE "B" AT BENTS NO. 2 AND NO. 5

SCALE: 1:5

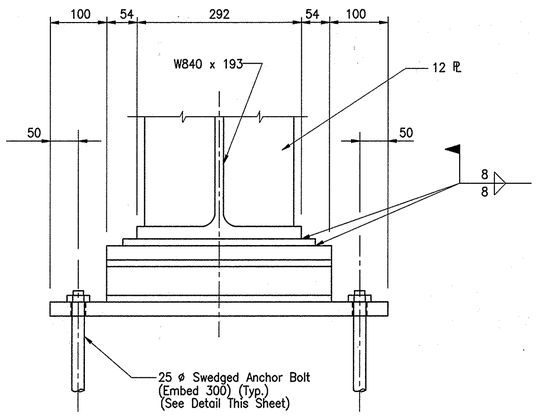

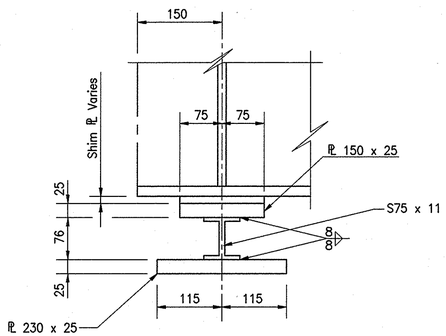

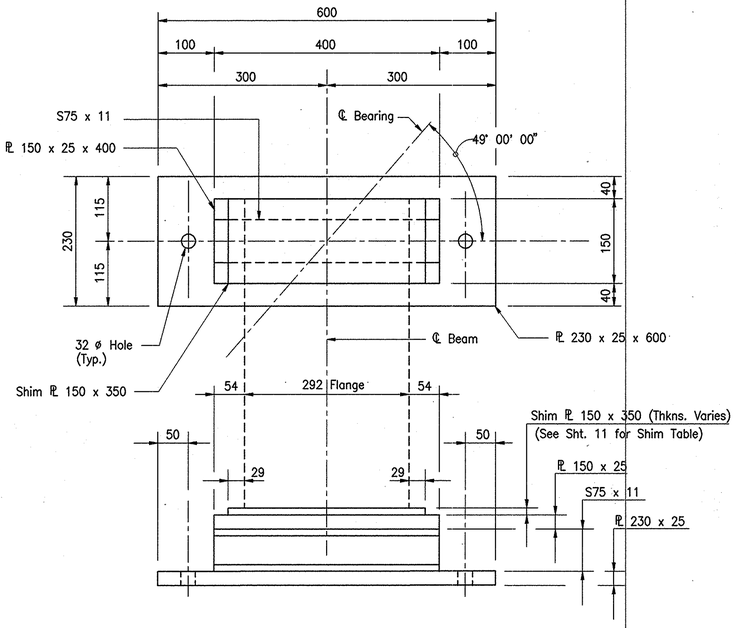

BEARING ASSEMBLY TYPE "A" AT BENTS NO. 1 AND NO. 6

SCALE: 1:5

NOTE

After bearings are set, screed elevations shall be determined by adding concrete dead load deflections given on drawing to the required final concrete elevations at all screed points. Take elevations at all screed points on top of the beams adjacent to screed point. Subtract these elevations from the elevation corrected for deflection, and use the resulting dimension as height for setting the screed from above that point. This Dimension remains constant regardless of how much or in what order the concrete is poured. Do not set screeds by leveling. Elevations will be furnished upon request.

NOTES:

All dimensions are in millimeters unless noted.

See Std. Dwg. No. 707-BEBP-01 for Type 2 Elastomeric Bearing Pad details

All Structural Steel to be A709-36.

Drwg. File: 95235TL3

FRANK EDWARD SAILER JR. REGISTERED No. 21453 STATE OF INDIANA PROFESSIONAL ENGINEER

RECOMMENDED FOR APPROVAL Frank E. Sailer Jr. 2-5-97
DESIGN ENGINEER DATE


DESIGNED: FES DRAWN: TLH

CHECKED: MJM CHECKED: FES

INDIANA DEPARTMENT OF TRANSPORTATION

BEARING DETAILS

HORIZONTAL SCALE	BRIDGE FILE
AS NOTED	8-75-4883B
VERTICAL SCALE	DESIGNATION
AS NOTED	8916700
SURVEY BOOK	SHEETS
	13 of 20
CONTRACT	PROJECT
B-23076	STP-4075( )

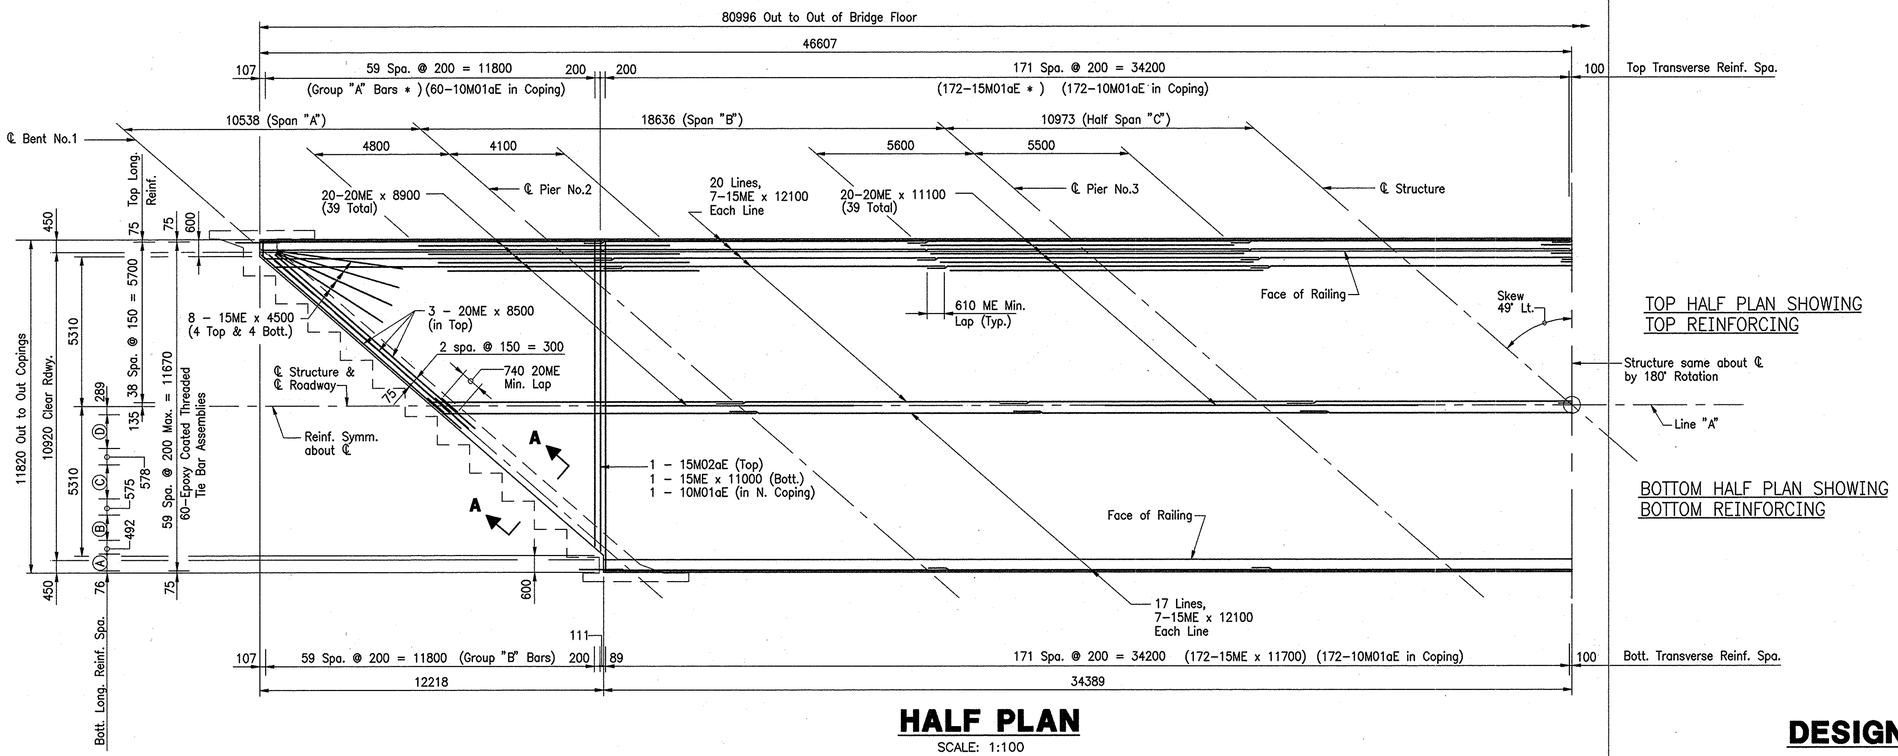

HALF PLAN


SCALE: 1:100

TOP HALF PLAN SHOWING
TOP REINFORCING

BOTTOM HALF PLAN SHOWING
BOTTOM REINFORCING

LEGEND

- Ⓐ 2 Spa. @ 300 = 600
- Ⓑ 3 Spa. @ 300 = 900
- Ⓒ 4 Spa. @ 300 = 1200
- Ⓓ 4 Spa. @ 300 = 1200
- ④ Indicates Beam Number
- * Tilt Hook Bars to Fit

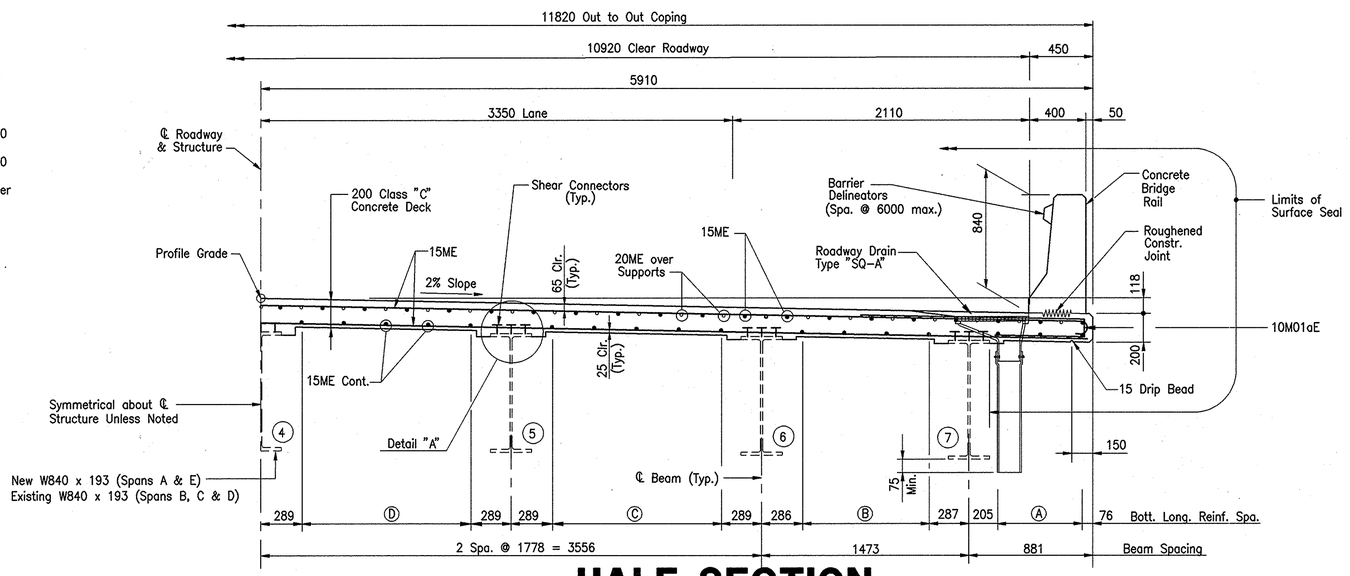

HALF SECTION

SCALE: 1:20

DESIGN DATA

Allowable Design Stresses:

Class "C" Concrete	f'c = 27 MPa
Class "A" Concrete	f'c = 24 MPa
Reinforcing Steel (Grade 60)	fy = 410 MPa

LIVE LOAD: HS20-44 Loading with impact and distribution of loads in accordance with 1992 AASHTO Specifications and Interim Specifications.

DEAD LOAD: Actual weight plus 1.7 kN/m2 (Composite) for future wearing surface and 0.7 kN/m2 (Non-Composite) for permanent metal deck forms.

Slab designed with a structural depth of 165.

NOTE:

For Section A-A, See Sht. No. 9.

All dimensions are in millimeters unless noted.

For Detail "A", Bar Bending Details and Bill of Materials, See Sht. No. 15.

"E" Designates Epoxy Coated Reinforcing Steel

For Concrete Bridge Rail Details, See Sht. No. 16 and 17.

For Roadway Drain Details, See Sht. 15.
Br. Stds. 704-BDCG-01 and 704-BDCG-04.

Permanent Metal Deck Forms may be substituted for Removable Forms on this Structure.

Screed Data will be furnished upon request.

Drwg. File: 9523SPR1

FRANK EDWARD SAUER JR. REGISTERED No. 21453 STATE OF INDIANA PROFESSIONAL ENGINEER

RECOMMENDED FOR APPROVAL Frank E. Sauer Jr. 2-5-97
DESIGN ENGINEER DATE


DESIGNED: MJM DRAWN: TLH
CHECKED: FES CHECKED: FES

INDIANA DEPARTMENT OF TRANSPORTATION


SUPERSTRUCTURE DETAILS

HORIZONTAL SCALE	BRIDGE FILE
AS NOTED	8-75-4883B
VERTICAL SCALE	DESIGNATION
AS NOTED	8916700
SURVEY BOOK	SHEETS
	14 of 20
CONTRACT	PROJECT
B-23076	STP/4075( )

Roadway Drain Type SQ w/Grate A
and 150 ø P.V.C. Pipe.
(See General Plan for Locations.)

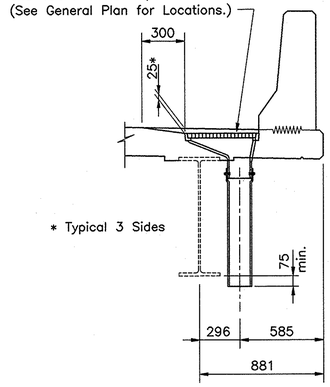

SECTION

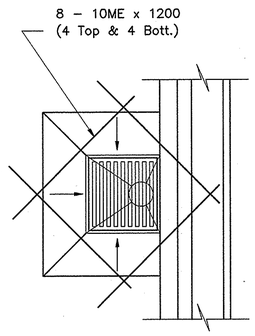

PLAN VIEW


NOTES

At locations of Roadway Drains, bend bottom reinforcing to miss Roadway Drains and cut top reinforcing in field to fit.

P.V.C. Pipe Shall be 150 ø Nominal Diameter Class 12454–B.

ROADWAY DRAIN DETAIL


SCALE: 1:20

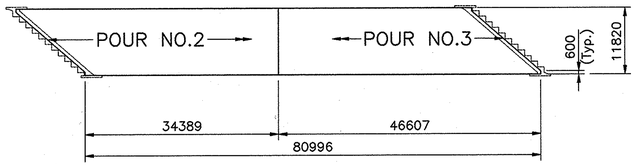

POUR DIAGRAM


SCALE: 1:500

NOTE: Pour No.2 or No.3 May Be Poured First. Deck to be Poured in Two Pours. Each Pour to Start at End Bent and Procede to ℄ Structure. (This Pouring Sequence and Direction of Pours IS NOT Optional.)

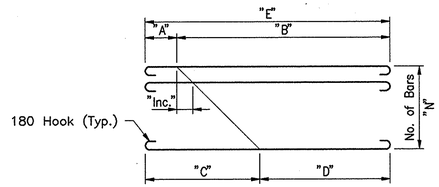


GROUP	SIZE	"A"	"B"	"C"	"D"	"E"	"INC."	"N"
"A"	15ME	570	10830	5616	5784	11400	174	30

GROUP "A" x 11760

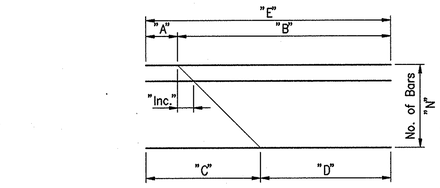

GROUP	SIZE	"A"	"B"	"C"	"D"	"E"	"INC."	"N"
"B"	15ME	570	10830	5616	5784	11400	174	30


GROUP "B" x 11400

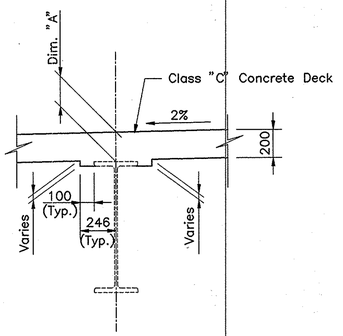

DETAIL "A"

NOT TO SCALE


TABLE OF FILLET DIMENSIONS							
BEAM NO.	①	②	③	④	⑤	⑥	⑦
DIM "A"	203	204	217	240	217	204	203

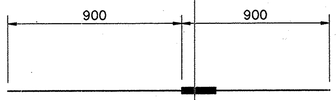


20M EPOXY COATED THREADED TIE BAR ASSEMBLY

(Extends from bridge deck into R.C. Bridge Approach)


NOT TO SCALE

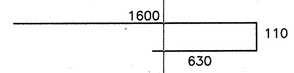

10M01aE x 2340

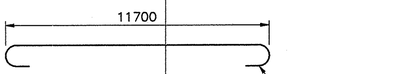

15M01aE x 12060

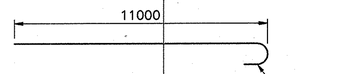

15M02aE x 11180

BILL OF MATERIALS FOR SUPERSTRUCTURE

EPOXY COATED REINFORCING STEEL			
SIZE OR MARK	NUMBER OF BARS	LENGTH (mm)	MASS (kg)
20ME	78	11100	
20ME	12	8500	
20ME	78	8900	
TOTAL 20ME			3914
GROUP "A"	60	11760	
GROUP "B"	60	11400	
15M01aE	344	12060	
15M02aE	2	11180	
15ME	518	12100	
15ME	344	11700	
15ME	2	11000	
15ME	16	4500	
TOTAL 15ME			25037
10M01aE	810	2340	
10ME	80	1200	
TOTAL 10ME			1563
TOTAL EPOXY COATED REINFORCING			30514
CONCRETE			
CLASS "C" CONCRETE			
POUR NO. 2			120.3 m3
POUR NO. 3			120.3 m3
TOTAL CONC. CLASS "C" IN SUPERSTR.			240.6 m3
MISCELLANEOUS			
** SURFACE SEAL (EST. 1359 m2)			LSUM ITEM
E.C. THREADED TIE BAR ASSEMBLIES			120 EACH
CAST IRON GRATES, BASINS & FITTINGS			871 kg
PIPE, P.V.C., 150 mm ø			8 m

** INCLUDES CONCRETE BRIDGE RAILING

NOTES

All Dimensions Are In Millimeters Unless Noted.

See Shts. 16 and 17 for Concrete Bridge Railing Details.

See Sht. 11 for Shear Connector Details.

See Std. Dwg. 703–BRST–01 for Reinf. Bar Notes.

See Std. Dwg. 704–BDCG–01 & 04 for Roadway Drain Type SQ and Grate A.

"E" Designates Epoxy Coated Reinforcing Steel.

Drwg. File: 9523SPR2

FRANK EDWARD SAILER JR. REGISTERED No. 21453 STATE OF INDIANA PROFESSIONAL ENGINEER


RECOMMENDED FOR APPROVAL Frank E. Sailer Jr. 2-5-97
DESIGN ENGINEER DATE

DESIGNED: MJM DRAWN: TLH
CHECKED: FES CHECKED: FES

INDIANA DEPARTMENT OF TRANSPORTATION

SUPERSTRUCTURE DETAILS

HORIZONTAL SCALE	BRIDGE FILE
AS NOTED	8–75–4883B
VERTICAL SCALE	DESIGNATION
AS NOTED	8916700
SURVEY BOOK	SHEETS
	15 of 20
CONTRACT	PROJECT
B-23076	STP/4075( )

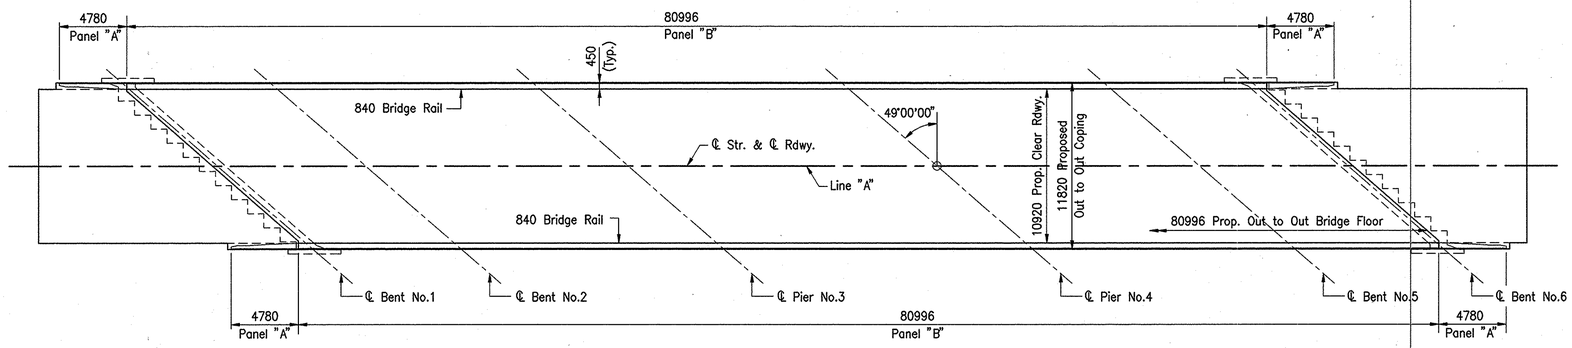


CONCRETE BRIDGE RAIL PLAN

SCALE: 1:200

* Panel "A" Details shown on Bridge Stds. No. 706-BRTT-01 thru No. 706-BRTT-08.

TYPICAL RAILING ELEVATION

Scale: 1:50

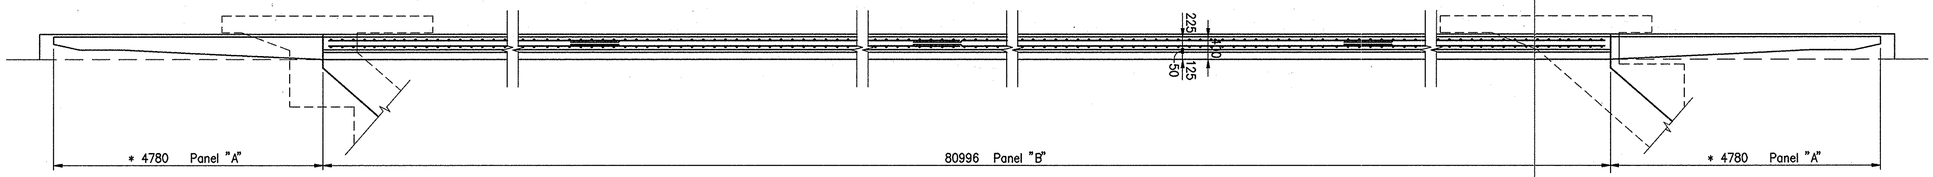

TYPICAL RAILING PLAN

Scale: 1:50

NOTE:

All dimensions are in millimeters unless noted.

For Bar Bending Details, Section "D-D" and Bill of Materials, see Sheet No. 17.

"E" Designates Epoxy Coated Reinforcing Steel.

Drwg. File: 9523RAL1

FRANK EDWARD SAUER JR. REGISTERED No. 21453 STATE OF INDIANA PROFESSIONAL ENGINEER

RECOMMENDED FOR APPROVAL Frank E. Sauer Jr. 2-5-97
DESIGN ENGINEER DATE


DESIGNED: MJM | DRAWN: TLH

CHECKED: FES | CHECKED: FES

INDIANA DEPARTMENT OF TRANSPORTATION

CONCRETE BRIDGE RAIL DETAILS

HORIZONTAL SCALE	BRIDGE FILE
AS NOTED	8-75-4883B
VERTICAL SCALE	DESIGNATION
AS NOTED	8916700
SURVEY BOOK	SHEETS
	16 of 20
CONTRACT	PROJECT
B-23076	STP/4075( )

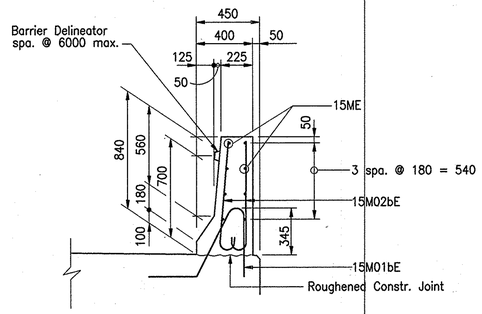


SECTION "D-D"


SCALE: 1:20

BILL OF MATERIALS FOR CONCRETE BRIDGE RAILING

EPOXY COATED REINFORCING STEEL			
SIZE OR MARK	NUMBER OF BARS	LENGTH (mm)	MASS (kg)
15M01bE	810	1510	
15M02bE	1620	940	
15ME	112	12300	
Total 15ME			6474
TOTAL EPOXY COATED REINFORCING STEEL			6474
CONCRETE			
CLASS "C" CONCRETE IN RAILING			
PANEL "B" (2 @ 19.5 m3)			39.0 m3
TOTAL CONC. CLASS "C" IN RAILING			39.0 m3
MISCELLANEOUS			
BARRIER DELINEATORS			30 EACH
CONC. BR. RAIL TRANS. TYPE TGB			4 EACH

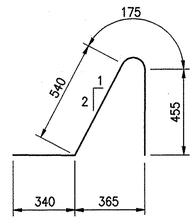

15M01bE x 1510

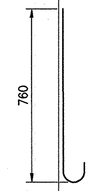

180 Hook

15M02bE x 940

NOTE:
All Dimensions Are In Millimeters.
For Reinforcing Bar Notes, see Br. Std. 703-BRST-01.
"E" Designates Epoxy Coated Reinforcing Steel.

Drwg. File: 9523RAL2

FRANK EDWARD SAILER JR. REGISTERED No. 21453 STATE OF INDIANA PROFESSIONAL ENGINEER


RECOMMENDED FOR APPROVAL Frank E. Sailer Jr. 2-5-97
DESIGN ENGINEER DATE

DESIGNED: MJM DRAWN: TLH
CHECKED: FES CHECKED: FES

INDIANA DEPARTMENT OF TRANSPORTATION

CONCRETE BRIDGE RAIL DETAILS

HORIZONTAL SCALE	BRIDGE FILE
AS NOTED	8-75-4883B
VERTICAL SCALE	DESIGNATION
AS NOTED	8916700
SURVEY BOOK	SHEETS
	17 of 20
CONTRACT	PROJECT
B-23076	STP-4075( )

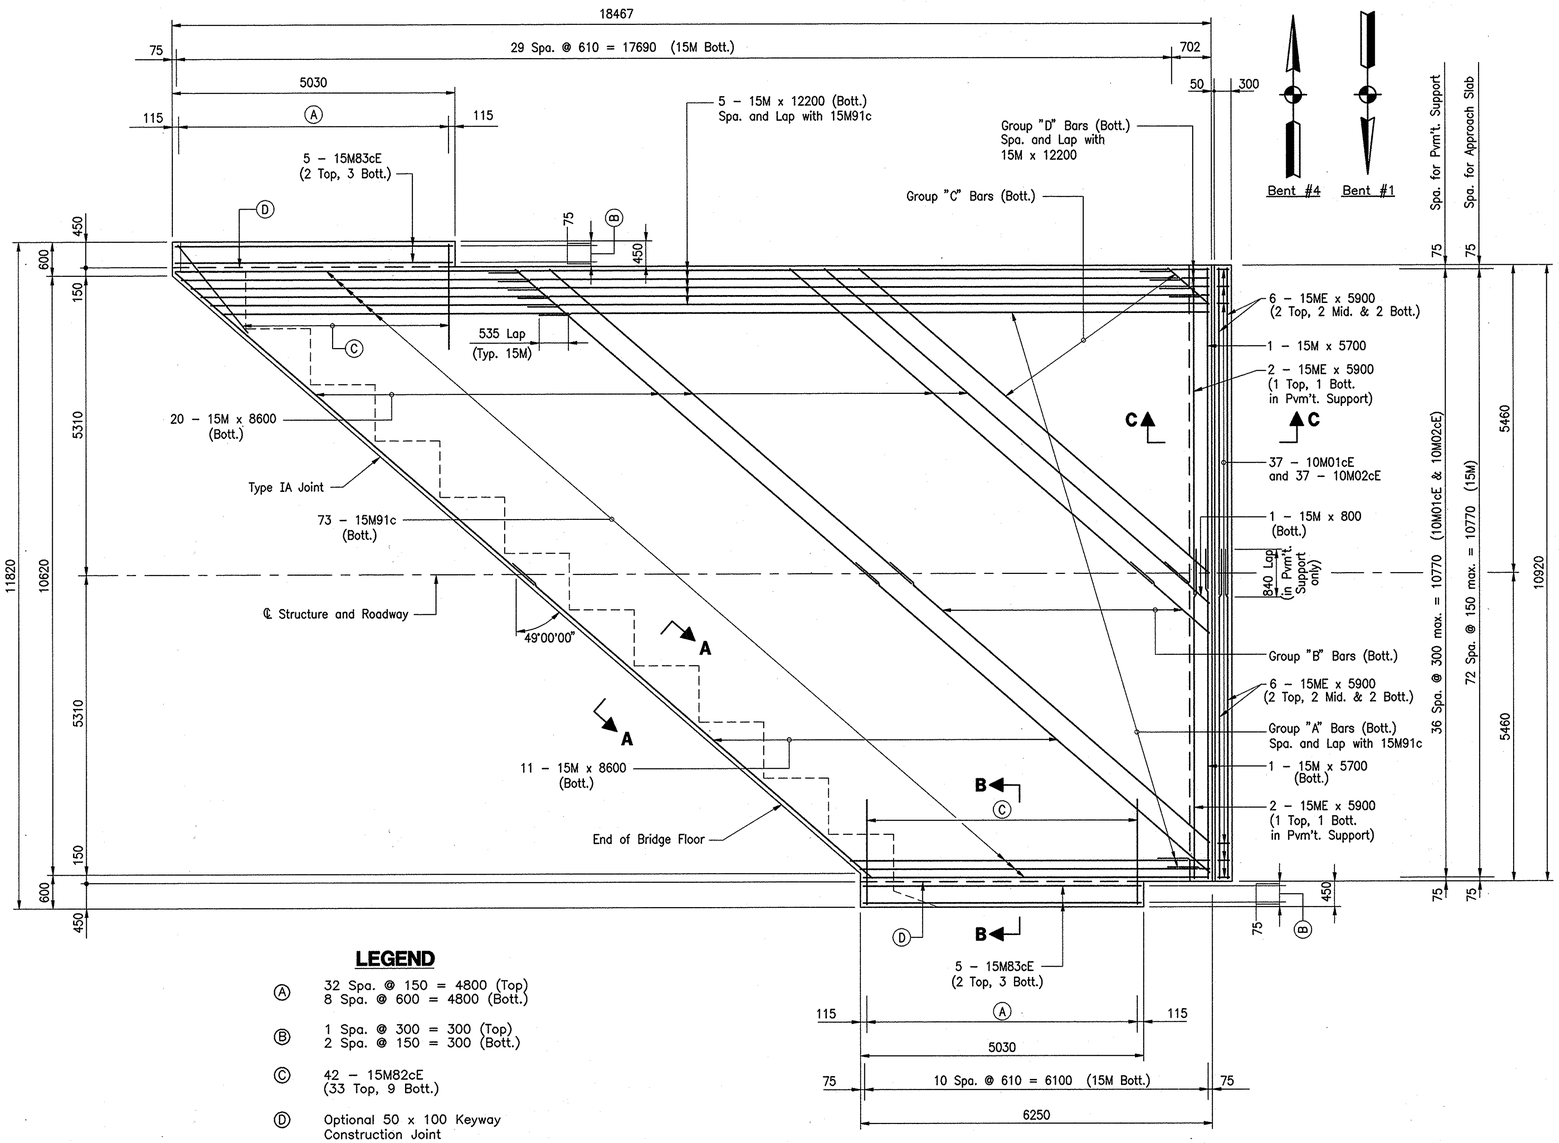

LEGEND

Ⓐ 32 Spa. @ 150 = 4800 (Top)
8 Spa. @ 600 = 4800 (Bott.)

Ⓑ 1 Spa. @ 300 = 300 (Top)
2 Spa. @ 150 = 300 (Bott.)


Ⓒ 42 – 15M82cE
(33 Top, 9 Bott.)

Ⓓ Optional 50 x 100 Keyway
Construction Joint

PLAN - EAST APPROACH


WEST APPROACH SAME BY 180° ROTATION

SCALE: 1 : 50

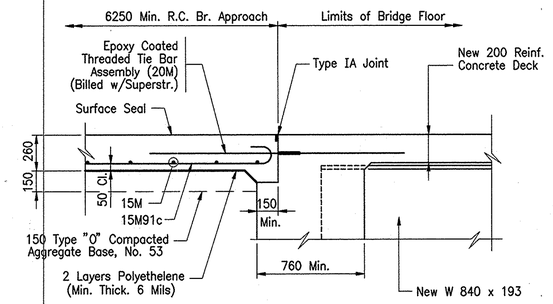

SECTION "A-A"

SCALE: 1:20

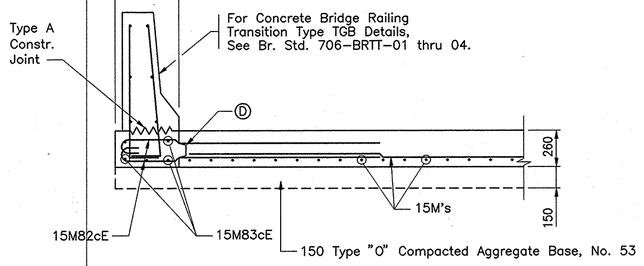

SECTION "B-B"

SCALE: 1:20

NOTES

"E" Designates Epoxy Coated Reinforcing Steel.

For Reinforcing Bar Notes, See Bridge Standard 703–BRST–01.

For Additional R.C. Bridge Approach Details, See Road Standards 610–RCBA–01 & 05.

All Dimensions are in Millimeters Except as Noted.

See Sht. 19 for Section "C–C", Bar Bending Details and Bill of Materials.

Drwg. File: 9523APP1

FRANK EDWARD SAILER REGISTERED No. 21453 STATE OF INDIANA PROFESSIONAL ENGINEER


RECOMMENDED FOR APPROVAL Frank E. Sailer Jr. 2-5-97
DESIGN ENGINEER DATE

DESIGNED: FES DRAWN: TLH
CHECKED: MJM CHECKED: FES

INDIANA DEPARTMENT OF TRANSPORTATION


R.C. BRIDGE APPROACH DETAILS

HORIZONTAL SCALE	BRIDGE FILE
AS NOTED	8–75–4883B
VERTICAL SCALE	DESIGNATION
AS NOTED	8916700
SURVEY BOOK	SHEETS
	18 of 20
CONTRACT	PROJECT
B-23076	STP–4075( )

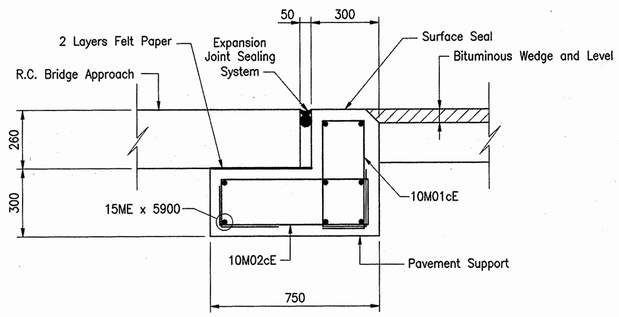


SECTION "C-C"


SCALE: 1:200

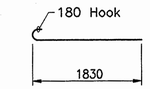


15M82cE x 2010

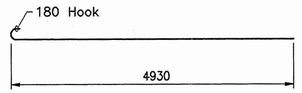


15M83cE x 5110

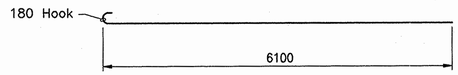


15M91c x 6280

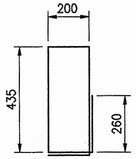

10M01cE x 1730

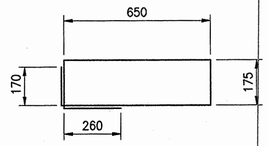

10M02cE x 2080

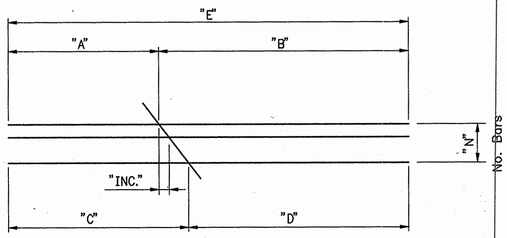

GROUP	SIZE	"A"	"B"	"C"	"D"	"E"	"INC."	"N"
"A"	15M	800	12000	6300	6500	12800	172	33
"B"	15M	1700	7300	4100	4900	9000	800	4
"C"	15M	790	8060	4020	4830	8850	808	5
"D"	15M	700	1250	880	1070	1950	183	2

GROUP "A" BARS (15M x 12800)
GROUP "B" BARS (15M x 9000)
GROUP "C" BARS (15M x 8850)
GROUP "D" BARS (15M x 1950)

BILL OF MATERIALS FOR R.C. BR. APPROACH (2 REQ'D.)

EPOXY COATED REINFORCING STEEL			
SIZE OR MARK	NUMBER OF BARS	LENGTH (mm)	WEIGHT (kg)
15M82cE	84	2010	
15M83cE	10	5110	
15ME	16	5900	
TOTAL 15ME			494
10M01cE	37	1730	
10M02cE	37	2080	
TOTAL 10ME			111
TOTAL EPOXY COATED REINFORCING STEEL			605
REINFORCING STEEL			
15M91c	73	6280	
GROUP "A"	33	12800	
GROUP "B"	4	9000	
GROUP "C"	5	8850	
GROUP "D"	2	1950	
15M	5	12200	
15M	31	8600	
15M	2	5700	
15M	1	800	
TOTAL 15M			2049
TOTAL REINFORCING STEEL			2049
CONCRETE			
CONCRETE CLASS "A"			
IN PAVEMENT SUPPORT			3.3 m2
MISCELLANEOUS			
PAVEMENT REMOVAL			95.2 m2
TYPE "O" COMP. AGG. BASE, NO. 53			50 Mg
CEMENT CONC. PVM'T., REINF., 260 mm			139.5 m2
SURFACE SEAL (EST. 138.3 m2)			LSUM
EXPANSION JOINT SEALING SYSTEM			10.9 m3

NOTES

"E" Designates Epoxy Coated Reinforcing Steel.

For Reinforcing Bar Notes, See Bridge Standard 703-BRST-01.

For Additional R.C. Bridge Approach Details, See Road Standards 610-RCBA-01 & 05.

All Dimensions are in Millimeters Except as Noted.

Drwg. File: 9523APP2

FRANK EDWARD SAILER JR. REGISTERED No. 21453 STATE OF INDIANA PROFESSIONAL ENGINEER

RECOMMENDED FOR APPROVAL Frank E. Sailer Jr. 2-5-97
DESIGN ENGINEER DATE

DESIGNED: FES DRAWN: TLH
CHECKED: MJM CHECKED: FES

INDIANA DEPARTMENT OF TRANSPORTATION

R.C. BRIDGE APPROACH DETAILS

HORIZONTAL SCALE	BRIDGE FILE
AS NOTED	8-75-4883B
VERTICAL SCALE	DESIGNATION
AS NOTED	8916700
SURVEY BOOK	SHEETS
	19 of 20
CONTRACT	PROJECT
B-23076	STP-4075( )

STRUCTURE QUANTITIES

ITEM	CONCRETE CLASS "C" IN SUPERSTR.	CONCRETE CLASS "A" IN SUBSTR.	CONCRETE CLASS "A"	CONCRETE RAILING CLASS "C"		REINF. STEEL	EPOXY COATED REINF. STEEL	STRUCT. STEEL *	TYPE "A" BEARING ASSEMBLY	TYPE "B" BEARING ASSEMBLY	FIELD DRILLED HOLE	PILES (WALL THICKNESS= 5.1 mm) STEEL ENCASED CONCRETE 356 ø		STEEL H PILE, 10x42		EPOXY COATED PILES, 255		P.V.C. PIPE 150 mm ø	P.V.C. PIPE 460 mm ø	CAST IRON GRATES, BASINS AND FITTINGS	260 REINF. CONCRETE PAVEMENT	TYPE "O" COMP. AGG. NO. 53	PAVEMENT REMOVAL	DRY EXCAVATION	B-BORROW FOR STR. BACKFILL	EPOXY C. THREADED TIE BAR ASSEMB.	CONC. BR. TRANSITION TYPE TGB	BARRIER DELINEATORS	SHEAR CONNECTOR	SURFACE SEAL (ESTIMATED) **	EXPANSION JOINT SEALING SYSTEM
	m3	m3	m3	m3	m	kg	kg	kg	EACH	EACH	EACH	NO.	m	NO.	m	NO.	m	m	m	kg	m2	Mg	m2	m3	m3	EACH	EACH	EACH	EACH	m2	m
STR. NO. 8-75-4883B																															
BENT NO. 1		17.7					3635		7			2	14						7.2						84	30					19.1	
BENT NO. 2		17.0				862				7																					
BENT NO. 5		17.0				862				7																					
BENT NO. 6		17.7					3635		7			2	11						7.2						84	30					19.1	
SUPERSTRUCTURE	240.6						30514	35867			578							8		871							120			3150	1044	
CONCRETE BRIDGE RAIL				39.0			6474																					4	30		315	
R.C. BRIDGE APPROACHES			6.6			4098	1210														279	100	190.4								276.6	21.8
TOTAL	240.6	69.4	6.6	39.0		5822	45468	35867	14	14	578	4	50					8	14.4	871	279	100	190.4	168	60	120	4	30	3150	1673.8	21.8

APPROACH STRUCTURES

STRUCTURE NUMBER	LOCATION	LEFT	RIGHT	CROSS	SIZE	DESCRIPTION GROUP	DESCRIPTION SEE RD. STD. SHEETS 715-PSDR-01 THRU 03 FOR ACCEPTABLE TYPE OF PIPE IN WITHIN EACH GROUP	LENGTH	SKEW	FLOW LINE COVER	FLOW LINE UP STREAM	FLOW LINE DOWN STREAM	CONCRETE CLASS "A"	"B" BORROW	METHOD OF BACKFILL	THICKNESS STEEL *	THICKNESS ALUM. *	VELOCITY	RIPRAP	PIPE END SECTION	REINF. STEEL	REMARKS	PLANS REF. SHEET NO.
					mm			m		m	ELEV.	ELEV.	m3	m3					m2	EACH	kg		
1	6+123.67			X	150		Perf. C.P.	27	49°													1 Delineator Post Required	
2	6+205.49			X	150		Perf. C.P.	27	49°													1 Delineator Post Required	
							TOTALS															Total of Reinf. Steel Carried to "Structure Quantities"	

LEGEND OF ABBREVIATION

F.B.C.C.S./P.I. _ _ FULLY BITUMINOUS COATED CORRUGATED STEEL WITH PAVED INVERT
F.B.C.C.A.A./P.I. _ FULLY BITUMINOUS COATED CORRUGATED ALUMINUM ALLOY WITH PAVED INVERT
F.B.C.C.S. _ _ _ _ FULLY BITUMINOUS COATED CORRUGATED STEEL
C.S. _ _ _ _ _ _ _ CORRUGATED STEEL
C.A.A. _ _ _ _ _ _ CORRUGATED ALUMINUM ALLOY
S.P.S. _ _ _ _ _ _ STRUCTURAL PLATE STEEL
F.B.C.P.C.S. _ _ _ FULLY BITUMINOUS COATED PERFORATED CORRUGATED STEEL
C.P. _ _ _ _ _ _ _ CORRUGATED PLASTIC

NOTES

* The weight of Structural Steel is approximate only, and it shall be the Contractors responsibility to determine the weight on which he bases his bid.

** The quantity for Surface Seal is approximate only, and it shall be the Contractors responsibility to determine the quantity on which he bases his bid.

For Test Bar Samples, see Bridge Standard 703-BRST-01.

DWG. FILE: 9523BSUM

FRANK EDWARD SAILER JR. REGISTERED No. 21453 STATE OF INDIANA PROFESSIONAL ENGINEER


RECOMMENDED FOR APPROVAL Frank E. Sailer Jr. 2-5-97
DESIGN ENGINEER DATE

DESIGNED: MJM DRAWN: TLH
CHECKED: FES CHECKED: FES

INDIANA DEPARTMENT OF TRANSPORTATION

BRIDGE SUMMARY

HORIZONTAL SCALE	BRIDGE FILE
NONE	8-75-4883B
VERTICAL SCALE	DESIGNATION
NONE	8916700
SURVEY BOOK	SHEETS
	20 of 20
CONTRACT	PROJECT
B-23076	STP-4075( )

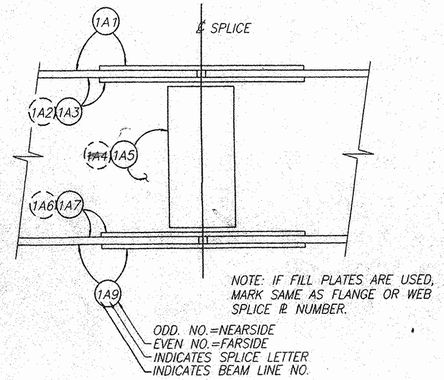

TYPICAL MATCHMARKING @ SPLICE

INDIANA DEPARTMENT OF TRANSPORTATION

CONTRACT No:	B-23076
STRUCT. NO:	8-75-4883B
PROJECT No:	STP/-40753(3)
COUNTY:	STARKE
CUSTOMER:	JACK ISOM CONSTUCTION CO., INC.
ISECO JOB NO:	B-2499

BOLT LIST

FIELD BOLT LOCATION

LOCATION (A325)		GRIP METRIC	GRIP ENGLISH	DIAMETER METRIC	DIAMETER ENGLISH	LENGTH METRIC	LENGTH ENGLISH	SHOP	FIELD
WEB SPLICE	(BOLT W/NUT)	40	1 9/16	22	7/8	76	3	588	1176
FLG SPLICE – w\ INSIDE BAR	(BOLT W/NUT)	46	1 13/16	22	7/8	83	3 1/4		392
FLG SPLICE – w\OUT INSIDE BAR	(BOLT W/NUT)	34	1 5/16	22	7/8	70	2 3/4		112
CONN. ℄ TO BEAMS	(BOLT W/NUT)	24	15/16	22	7/8	57	2 1/4		240
CONN. ℄ TO DIAPH.	(BOLT W/NUT)	21	13/16	22	7/8	57	2 1/4	240	1332
HARD FLAT WASHER				22	7/8			240	1920
25ø X 375 ANCHOR BOLTS – SEE DET.									28

FABRICATION AND ERECTION NOTES

ALL STRUCTURAL STEEL SHALL CONFORM TO A709-M GR.250 UNLESS NOTED OTHERWISE.

BOLTED CONNECTIONS SHALL BE MADE WITH HIGH STRENGTH BOLTS M22 DIAMETER UNLESS NOTED OTHERWISE. OPEN HOLES SHALL BE 24MM UNLESS NOTED.

ALL PAINT SHALL BE IN ACCORDANCE WITH THE CURRENT STATE HIGHWAY SPECIFICATIONS. SHOP PAINT: H.S. ZINC SILICATE PAINT; FIELD PAINT: MUST BE COMPATIBLE WITH SHOP COAT (VALSPAR V13-F12).

STRUCTURAL STEEL FOR WELDING MAY BE FLAME CUT IF THE FLAME CUTTING IS MECHANICALLY GUIDED. HAND FLAME CUTTING SHALL BE USED ONLY WHEN APPROVED AND THE SURFACE IS FURTHER TREATED BY MILLING AND GRINDING OR CHIPPING AND GRINDING.

IF CURVES IN PLATE AND ANGLES ARE FLAME CUT, THEY SHALL BE GROUND SMOOTH.

BEAMS MUST BE CAMBERED TO A SMOOTH CURVE. CAMBER MUST BE CHECKED AFTER WELDING IS COMPLETED AND WHILE BEAMS ARE SUPPORTED IN SUCH A WAY AS TO HAVE NO BENDING MOMENT IN THE DIRECTION OF CAMBER.

WHEN THE BEAM SECTIONS ARE FIT UP IN THE SHOP FOR REAMING OR DRILLING OF FIELD SPLICES, THE CENTERLINE OF THE OPPOSING FLANGES SHALL NOT DEVIATE MORE THAN 3MM. WITH THE WEBS IN ALIGNMENT.

HOLES FOR BEAM SPLICES AND SPLICE PLATES SHALL BE DRILLED FULL SIZE WHILE ASSEMBLED.

DIAMETER OF HOLES IN ALL MATERIAL CONNECTION TOP SHOES OR BEARING PLATE TO BEAM FLANGES TO BE 3MM. LARGER THAN THE DIAMETER OF THE BOLTS. BOLTS CONNECTING BEAM FLANGE TO TOP SHOE SHALL EXTEND INTO THE TOP SHOE A MINIMUM OF 25.4MM.

SHIMS BETWEEN BEAMS AND TOP SHOE OR BEARING PLATE MAY BE BUILT-UP. NO SHIM SHALL BE LESS THAN 3MM. THICKNESS.

CLEANING: ALL SURFACES TO BE BLASTED TO SSP-SP10 TO A PROFILE OF 1 TO 2.5 MILS.

SHOP PLANS
Indiana Department of Highways
APPROVED AS NOTED
SUBJECT TO CONDITIONS WRITTEN BELOW
DATE: 7/15/97 CKD. BY MM
NOTE: THIS DRAWING CHECKED FOR DESIGN FEATURES ONLY. CONTRACTOR IS RESPONSIBLE FOR DIMENSIONS, ACCURACY, AND FIT OF WORK.

FOR APPROVAL
DATE JUL 08 1997

THIS DRAWING AND ALL INFORMATION THEREON IS THE PROPERTY OF INDIANA STEEL & ENGINEERING CORP. AND IS CONFIDENTIAL AND MUST NOT BE MADE PUBLIC OR COPIED WITHOUT THEIR EXPRESSED WRITTEN AUTHORITY AND IS SUBJECT TO RECALL UPON THEIR DEMAND.

ERECTOR NOTE:
(1) INSTALL MEMBERS WITH MARK AT END SHOWN ON PLAN
(2)


HOLES BOLTS UNLESS NOTED

1	4
2	5
3	6

APP. | APP. RECD. | RE-APP.
SHOP | DIST. | ERECTOR
ARCHITECT
DR. BY SEAN DATE 7-7-97
CHK. JAKN DATE 7-8-97
CUSTOMER
JOB LOCATION
SHOP PAINT


INDIANA STEEL & ENGINEERING CORP.
957 J Street – P.O. Box 668 – Area 812 275-3363
BEDFORD, INDIANA 47421

SH. OF
JOB NO. B-2499
DRAWING NO. TITLE

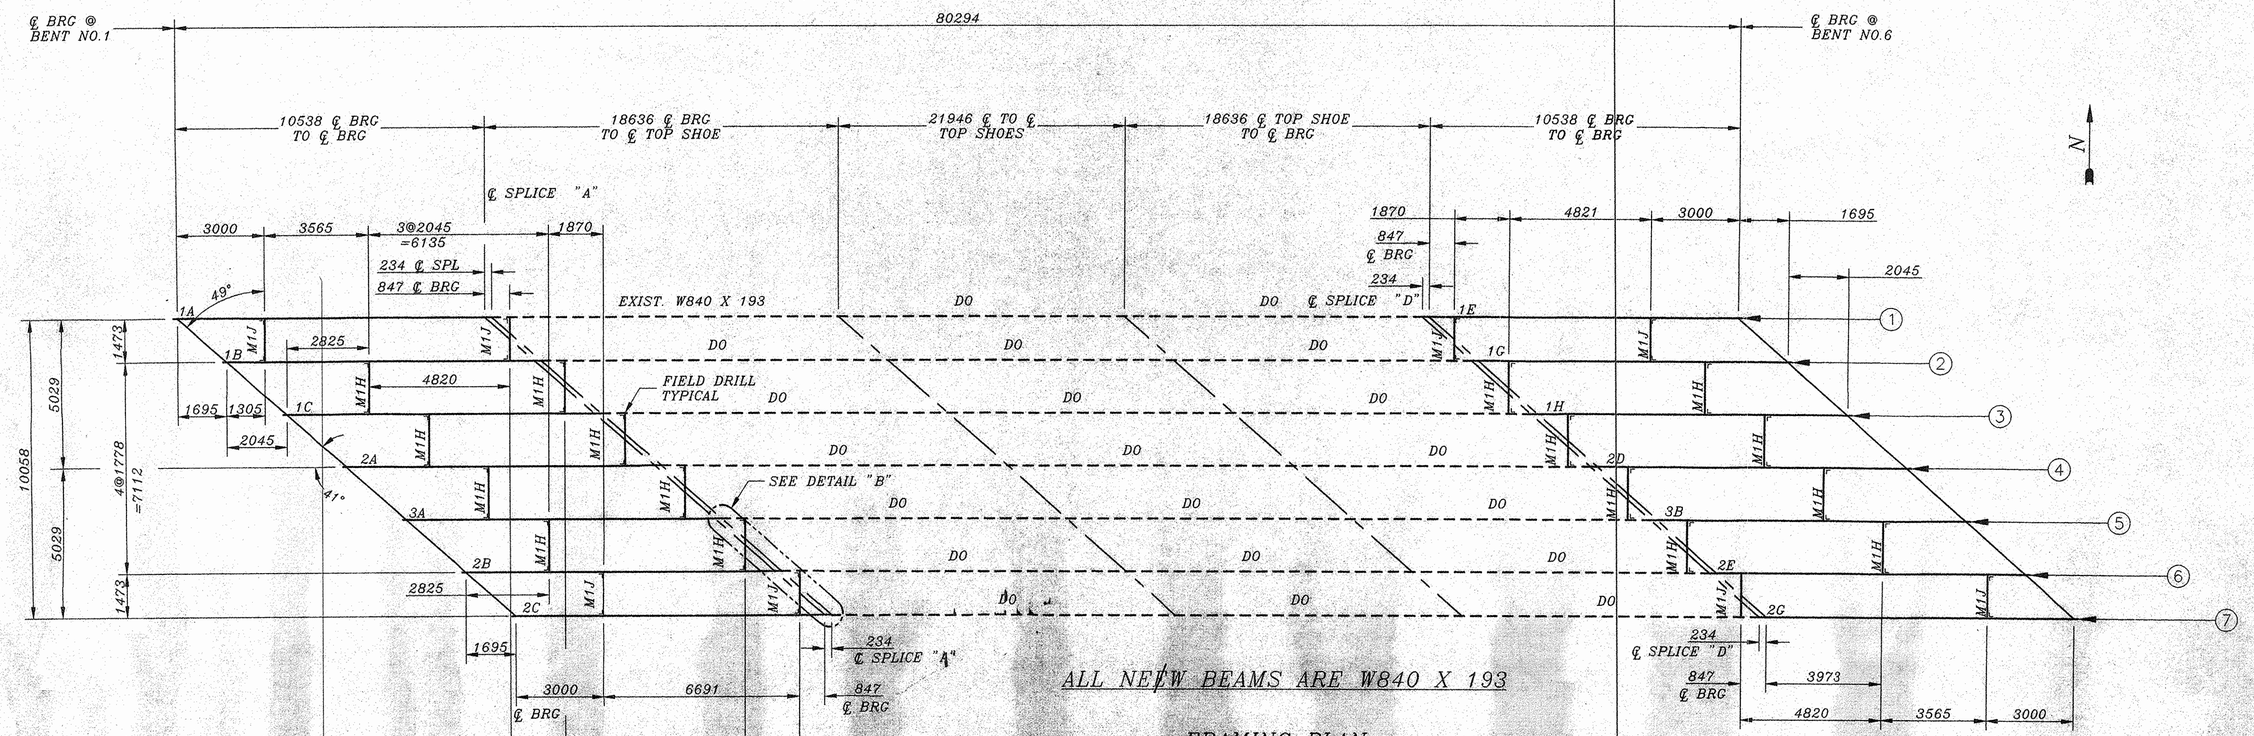


ALL NEW BEAMS ARE W840 X 193

FRAMING PLAN

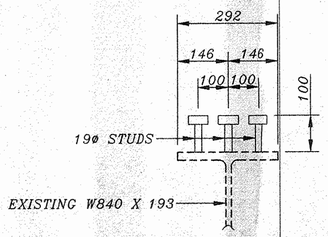

TYPICAL SHEAR CONNECTION DETAIL

SUPPLIED & APPLIED BY OYTHERS

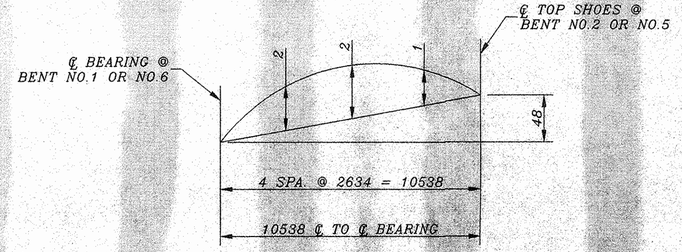

NO LOAD CAMBER DIAGRAM NEW BEAMS

SHIM TABLE

LOCATION	BENT #1	BENT #6
BEAM #1	11 – S1C	30 – S1E
BEAM #2	50 – S1J	20 – S1D
BEAM #3	11 – S1C	32 – S1C
BEAM #4	35 – S1H	35 – S1H
BEAM #5	32 – S1C	11 – S1C
BEAM #6	20 – S1D	50 – S1J
BEAM #7	30 – S1E	11 – S1C

SHOP PLANS
Indiana Department of Highways
APPROVED As NOTED
SUBJECT TO CONDITIONS WRITTEN BELOW
DATE: 7/15/97 CKD. BY MM Sligh
NOTE: THIS DRAWING CHECKED FOR DESIGN FEATURES ONLY. CONTRACTOR IS RESPONSIBLE FOR DIMENSIONS, ACCURACY, AND FIT OF WORK.

FOR APPROVAL
DATE JUL 08 1997

NOTES:

1 – ALL MATERIAL ON THIS SHEET TO BE A709 GR36 UNLESS NOTED.
2 – MATERIAL DESIGNATED (CVN) SHALL MEET THE SPECIFIED MINIMUM TOUGHNESS REQUIREMENTS PER SPEC 711.01 910.02
3 – * = NO MILL CERTS REQ'D. THIS SHT.
4 – ITEM 513 – AISC CATAGORY I.

PROJECT NO. ..... STP-4075(3)
STRUCTURE NO. B-75-4883B
CONTRACT NO. B-23076
COUNTY ..... STARKE
STATE ..... INDIANA

THIS DRAWING AND ALL INFORMATION THEREON IS THE PROPERTY OF INDIANA STEEL & ENGINEERING CORP. AND IS CONFIDENTIAL AND MUST NOT BE MADE PUBLIC OR COPIED WITHOUT THEIR EXPRESSED WRITTEN AUTHORITY AND IS SUBJECT TO RECALL UPON THEIR DEMAND.

ERECTOR NOTE:
(1) INSTALL MEMBERS WITH MARK AT END SHOWN ON PLAN
(2)


HOLES 240 BOLTS 7/8Ø A325 UNLESS NOTED

1		4			
2		5			
SHOP	DIST.	ERECTOR	APP.	APP. RECD.	RE-APP.


ARCHITECT: INDIANA DEPARTMENT OF TRANSPORTATION
DR. BY: SEAN DATE 7-7-97 CHK. DATE 7/7/97
CUSTOMER: JACK ISOM CONST. CO., INC.
JOB LOCATION:
SHOP PAINT: ZINC PRIMER

INDIANA STEEL & ENGINEERING CORP.
957 J Street – P.O. Box 668 – Area 812 275-3363
BEDFORD, INDIANA 47421


SH. OF JOB NO. B-2499 DRAWING NO. E1

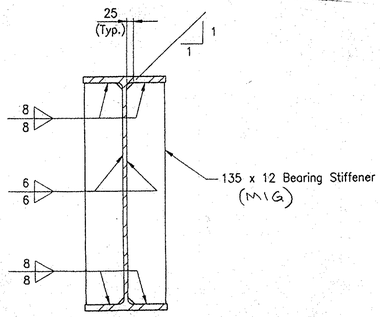


BEARING STIFFENER DETAIL

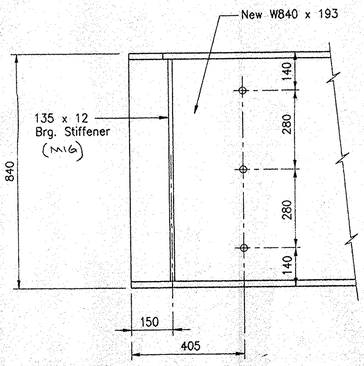



BEAM ELEVATION AT BENT NO.1 OR NO.6

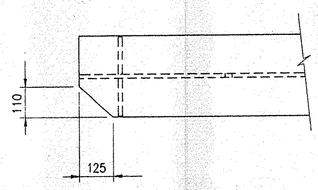

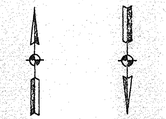


TOP FLANGE PLAN AT END OF BEAM AT BENT NO.1 OR NO.6

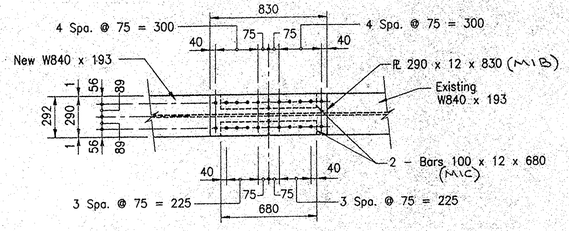

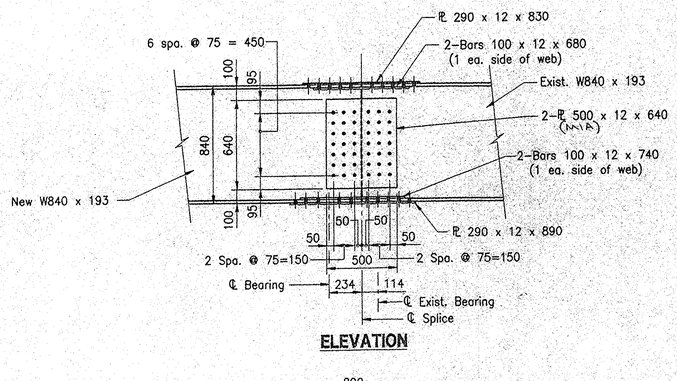


ELEVATION

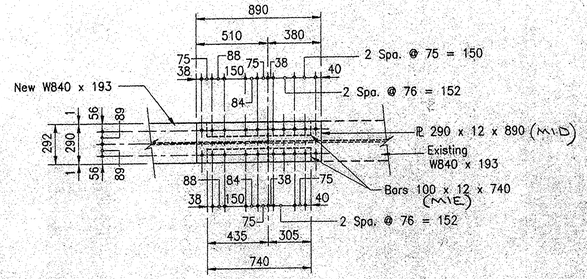


NEW SPLICE DETAIL

SPAN "A"
SPAN "D" - ROTATE 180°

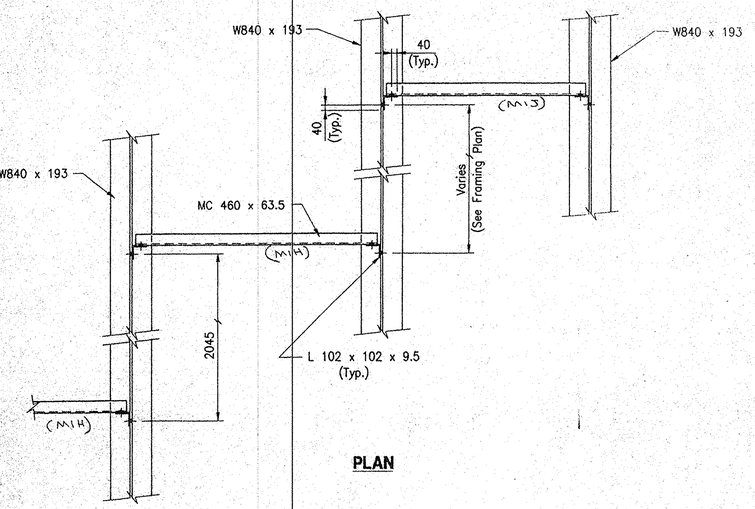

PLAN

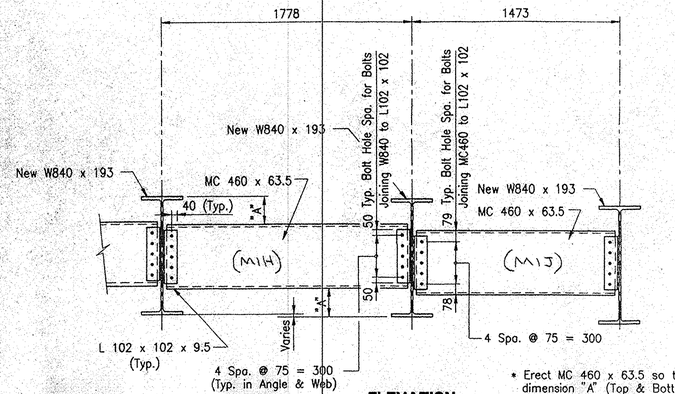

ELEVATION

* Erect MC 460 x 63.5 so that dimension "A" (Top & Bott.) will be equal ± 25.

DETAIL "B"

SHOP PLANS
Indiana Department of Highways
APPROVED ~~AS NOTED~~
SUBJECT TO CONDITIONS WRITTEN BELOW
DATE: 7/15/97 CKD. BY MA
NOTE: THIS DRAWING CHECKED FOR DESIGN FEATURES ONLY. CONTRACTOR IS RESPONSIBLE FOR DIMENSIONS, ACCURACY, AND FIT OF WORK.

NOTES:

All Structural Steel to be A709-36.

FOR APPROVAL
DATE JUL 08 1997

THIS DRAWING AND ALL INFORMATION THEREON IS THE PROPERTY OF INDIANA STEEL & ENGINEERING CORP AND IS CONFIDENTIAL AND MUST NOT BE MADE PUBLIC OR COPIED WITHOUT THEIR EXPRESSED WRITTEN AUTHORITY AND IS SUBJECT TO RECALL UPON THEIR DEMAND


ERECTOR NOTE
(1) INSTALL MEMBERS WITH MARK AT END SHOWN ON PLAN
(2)


HOLES 24Ø BOLTS 22Ø A325 UNLESS NOTED


1		4		APP	APP RECD	RE-APP	ARCHITECT IN.DOT.		CUSTOMER JACKSON CONST. CO., INC.	SHOP PAINT ZINC PRIMER	
2		5		SHOP	DIST.	ERECTOR	DR BY SEAN DATE 6-24-97	CHK JAWH DATE 7-8-97	JOB LOCATION STARKE COUNTY, IN.		
3		6									

INDIANA STEEL & ENGINEERING CORP.
957 J Street – P.O. Box 668 – Area 812 275-3363
BEDFORD, INDIANA 47421


SH OF
JOB NO B-2499
DRAWING NO E2

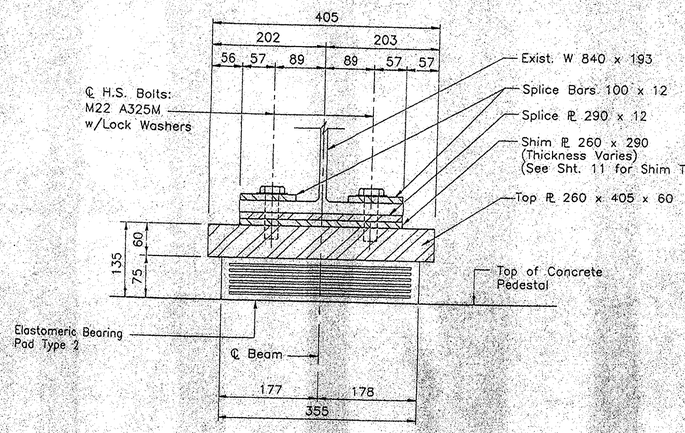

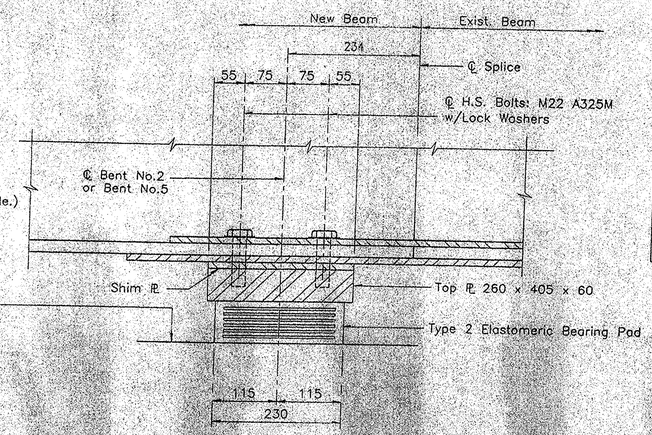

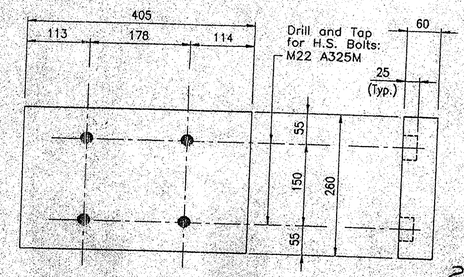


TOP PLATE

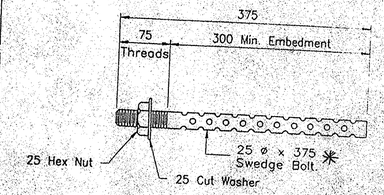



28 - ANCHOR BOLT DETAIL - S1B


BEARING ASSEMBLY TYPE "B" AT BENTS NO. 2 AND NO. 5

BY OTHERS

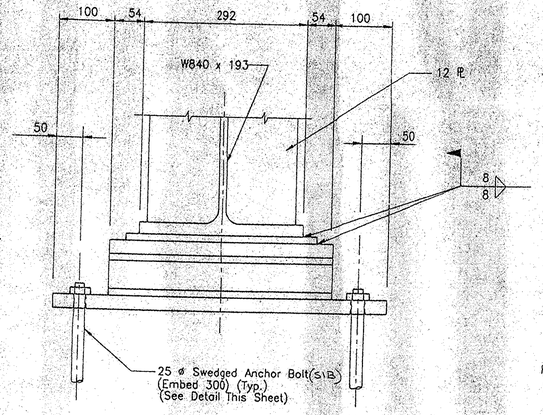

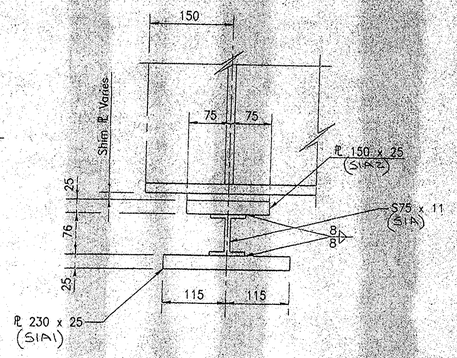

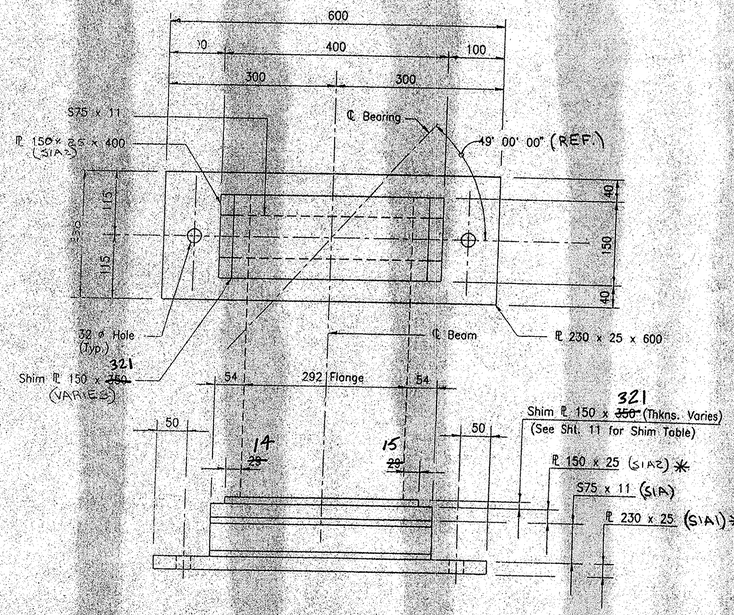

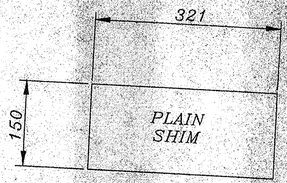

SHIM LIST

4 - SHIMS 150 X 11 X 321 - S1C ✱
2 - SHIMS 150 X 20 X 321 - S1D ✱
2 - SHIMS 150 X 30 X 321 - S1E ✱
2 - SHIMS 150 X 32 X 321 - S1C ✱
2 - SHIMS 150 X 35 X 321 - S1H ✱
2 - SHIMS 150 X 50 X 321 - S1J ✱

SEE SHIM TABLE SHT. E1

SHOP PLANS
Indiana Department of Highways
APPROVED As Noted
SUBJECT TO CONDITIONS WRITTEN BELOW
DATE: 7/15/97 CKD. BY MM Boyll
NOTE: THIS DRAWING CHECKED FOR DESIGN FEATURES ONLY. CONTRACTOR IS RESPONSIBLE FOR DIMENSIONS, ACCURACY, AND FIT OF WORK.

14 - BEARING ASSEMBLY TYPE "A" - S1A AT BENTS NO. 1 AND NO. 6

FOR APPROVAL
DATE JUL 08 1997

CONTRACT NO.....B-23076
PROJECT NO.....STP-4075(3)
STRUCTURE NO.....8-75-48836
COUNTY.....STARKE
STATE.....INDIANA

NOTE:
1 - ALL MATERIAL ON THIS SHEET TO BE A709M GR.250 UNLESS NOTED
✱ - NO MILL CERTS REQUIRED.

THIS DRAWING AND ALL INFORMATION THEREON IS THE PROPERTY OF INDIANA STEEL & ENGINEERING CORP. AND IS CONFIDENTIAL AND MUST NOT BE MADE PUBLIC OR COPIED WITHOUT THEIR EXPRESSED WRITTEN AUTHORITY AND IS SUBJECT TO RECALL UPON THEIR DEMAND

ERECTOR NOTE
(1) INSTALL MEMBERS WITH MARK AT END SHOWN ON PLAN
(2)

NOLES 240 BOLTS 220 A325 NOTED LINE FOR

1	4	APP.	APP. RECD. / REAPP.
2	5	SHOP	DIST. / ERECTOR
3	6		

ARCHITECT IN.D.O.T.
DR BY SEAN DATE 6-24-97 CHK JOHN DATE 7-8-97
CUSTOMER JACKSON CONST. CO., INC.
JOB LOCATION STARKE COUNTY, IND.
SHOP PAINT ZINC PRIMER

INDIANA STEEL & ENGINEERING CORP.
957 J Street – P.O. Box 668 – Area 812 275 3363
BEDFORD, INDIANA 47421

SHT. NO. 1 OF JOB NO. B-2499 DRAWING NO. S1

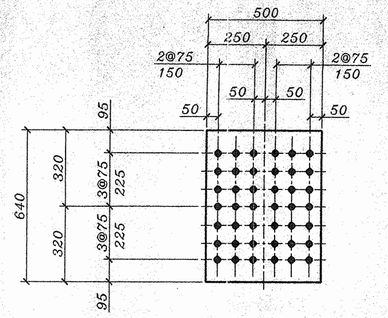


PLATE - 12 X 500 X 640
(A709-M / GR 250 <NTR>)
@ ALL LINES

28-WEB SPLICE PLATE - M1A


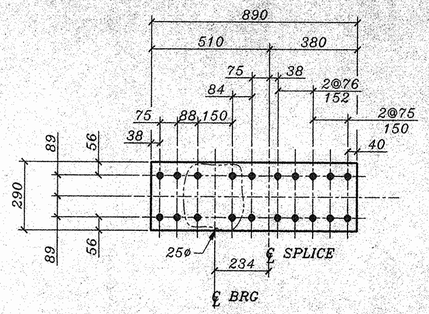


PLATE - 12 X 290 X 890
(A709-M / GR 250 <NTR>)
@ ALL LINES
PL'S FOR SPAN "A" AS SHOWN
PL'S FOR SPAN "D" ROTATED 180°

14-BOT. FLG. SPLICE PLATE - M1D

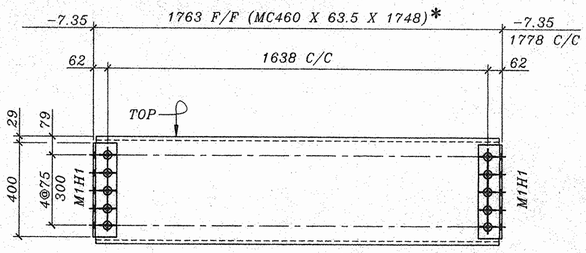

ALL HOLES 25ø

ALL ANGLES ARE M1H1*
102 X 102 X 9.5 X 400
(SHIP BOLTED)
OSLG = 62 / GRIP = 26

16-INT. DIAPH-M1H

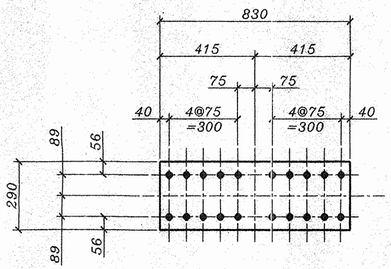


PLATE - 12 X 290 X 830
(A709-M / GR 250 <NTR>)
@ ALL LINES

14-TOP FLG. SPLICE PLATE - M1B


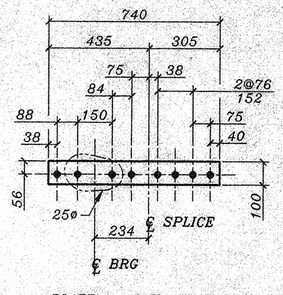


PLATE - 12 X 100 X 740
(A709-M / GR 250 <NTR>)
@ ALL LINES
PL'S FOR SPAN "A" AS SHOWN
PL'S FOR SPAN "D" ROTATED 180°

28-BOT. FLG. SPLICE BARS - M1E

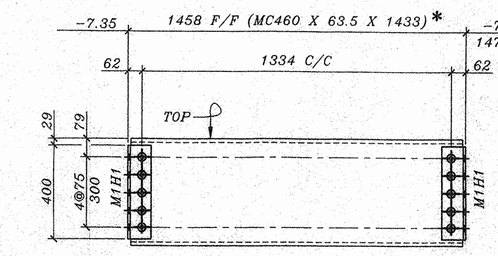

ALL HOLES 25ø

ALL ANGLES ARE M1H1 *
102 X 102 X 9.5 X 400
(SHIP BOLTED)
OSLG = 62 / GRIP = 26

8-INT. DIAPH-M1J

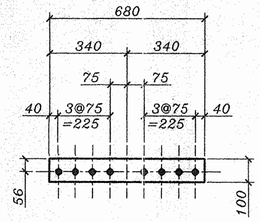


PLATE - 12 X 100 X 680
(A709-M / GR 250 <NTR>)
@ ALL LINES

28-TOP FLG. SPLICE BARS - M1C

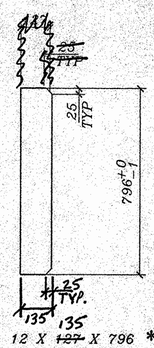


PLATE - 12 X ~~127~~ X 796 *
(A709-M / GR 250)
@ ALL LINES

28-ANCHOR BARS - M1C

SHOP PLANS
Indiana Department of Highways
APPROVED As NOTED
SUBJECT TO CONDITIONS WRITTEN BELOW
DATE: 7/15/97 CKD. BY MM
NOTE: THIS DRAWING CHECKED FOR DESIGN FEATURES ONLY. CONTRACTOR IS RESPONSIBLE FOR DIMENSIONS, ACCURACY, AND FIT OF WORK.

FOR APPROVAL
DATE JUL 18 1997

CONTRACT NO.....B-23076
PROJECT NO.....STP-4075(3)
STRUCTURE NO.....8-75-4883B
COUNTY.....STARKE
STATE.....INDIANA

NOTE:
1 - ALL MATERIAL ON THIS SHEET TO BE A709M GR.250 UNLESS NOTED
2 - NTR INDICATES MATERIAL TO MEET "SUPPLEMENTAL REQUIREMENTS FOR NOTCH TOUGHNESS ZONE 2".
3 - DRILL ALL SPLICE HOLES 24ø FOR 22ø A325 BOLTS FROM SOLID @ LAYDOWN. USE SPLICE PLATES AS TEMPLATES (TYP).
4 - ALL BEAMS NATURAL CAMBER UP. (TYP.)
5 - ALL DIMENSIONS GIVEN IN MILLIMETERS(mm).
* - NO MILL CIRTS REQUIRED.

THIS DRAWING AND ALL INFORMATION THEREON IS THE PROPERTY OF INDIANA STEEL & ENGINEERING CORP. AND IS CONFIDENTIAL AND MUST NOT BE MADE PUBLIC OR COPIED WITHOUT THEIR EXPRESSED WRITTEN AUTHORITY AND IS SUBJECT TO RECALL UPON THEIR DEMAND.

ERECTOR NOTE:
(1) INSTALL MEMBERS WITH MARK AT END SHOWN ON PLAN
(2)


HOLES	BOLTS	UNLESS NOTED
24ø	22ø A325	

1		4	
2		5	

APP.	APP. RECD.	RE-APP.	ARCHITECT	CUSTOMER	SHOP PAINT
SHOP	DIST.	ERECTOR	INDIANA DEPARTMENT OF TRANSPORTATION	JACK ISOM CONSTRUCTION COMPANY, INC.	ZINC PRIMER
			DR. BY SEAN DATE 6/16/97 CHK. DATE 7-8-97	JOB LOCATION SEE ABOVE	


INDIANA STEEL & ENGINEERING CORP.
957 J Street - P.O. Box 668 - Area 812 275-3363
BEDFORD, INDIANA 47421

SH. OF
JOB NO. B-2499
DRAWING NO. M1

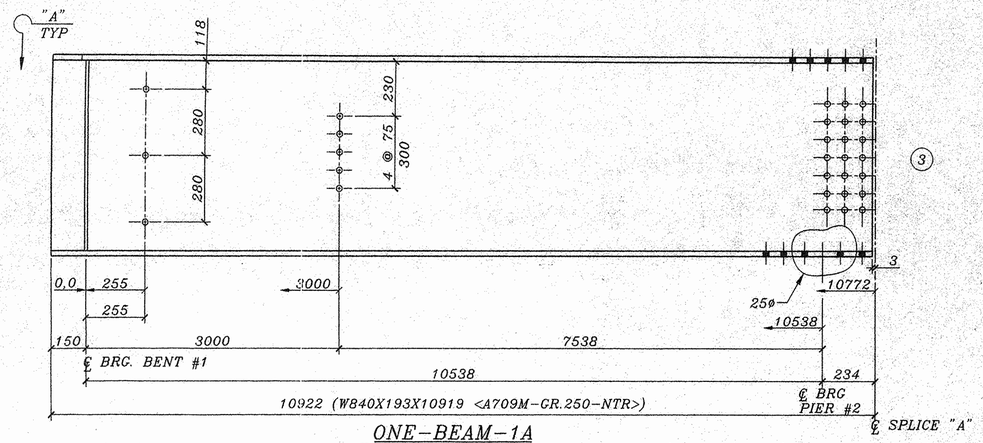


ONE-BEAM-1A

LINE (1) BENT #1 TO SPLICE "A"

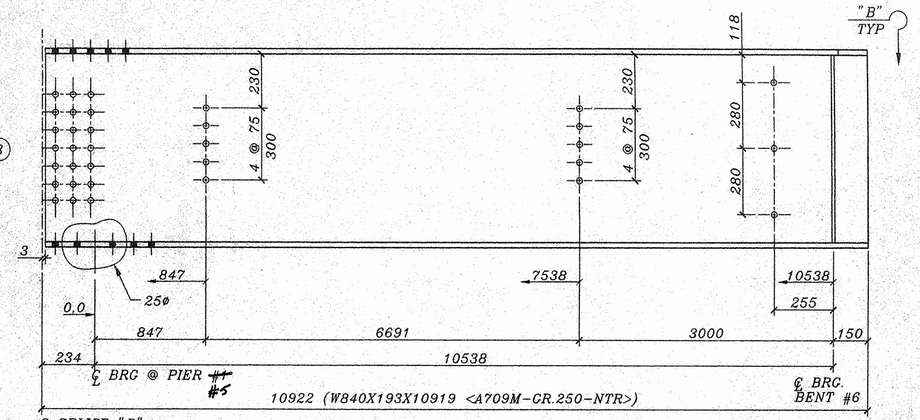


ONE-BEAM-1E

LINE (1) BENT #6 TO SPLICE "D"

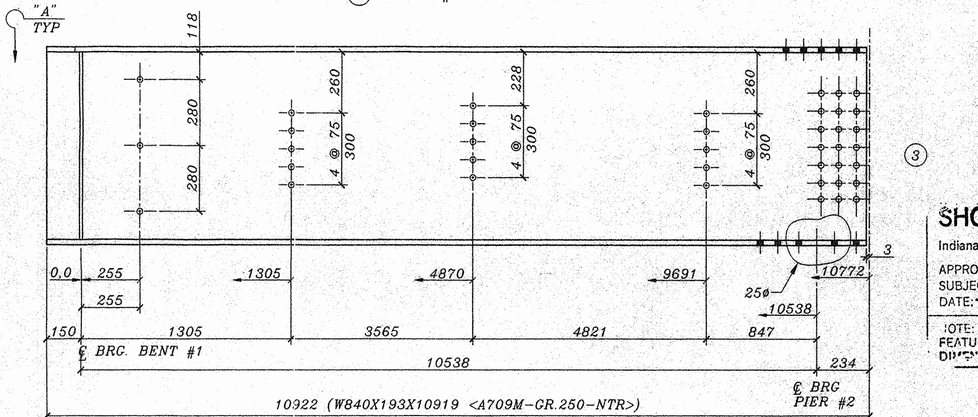


ONE-BEAM-1B

LINE (2) BENT #1 TO SPLICE "A"

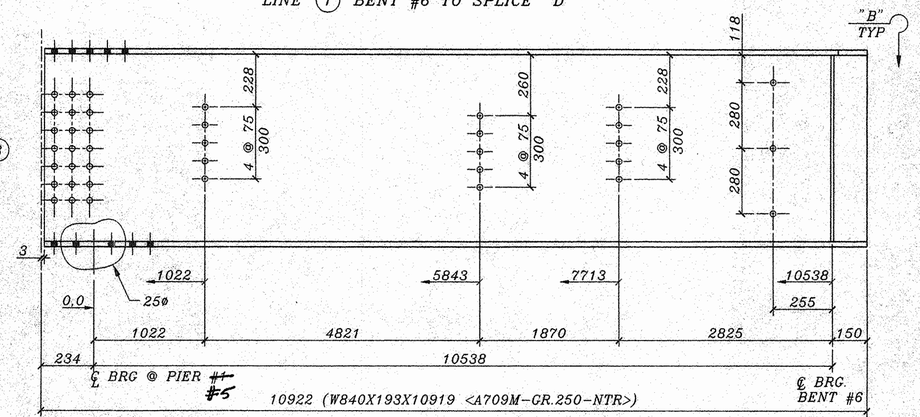


ONE-BEAM-1C


LINE (2) BENT #6 TO SPLICE "D"

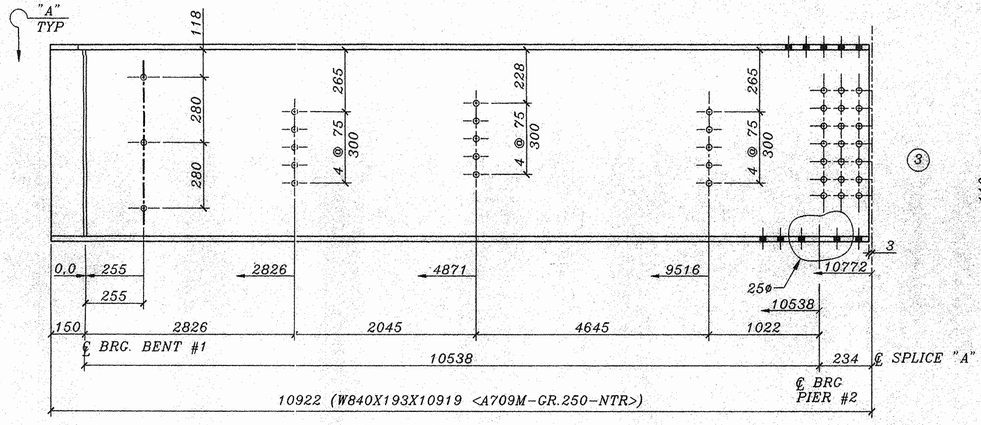



ONE-BEAM-1C

LINE (3) BENT #1 TO SPLICE "A"

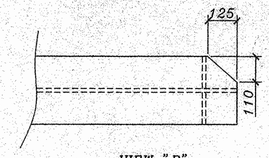

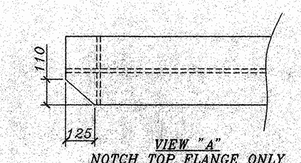

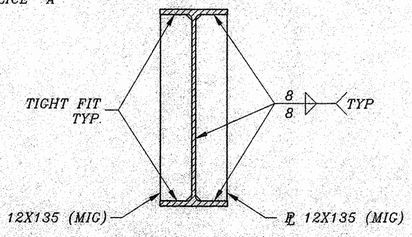

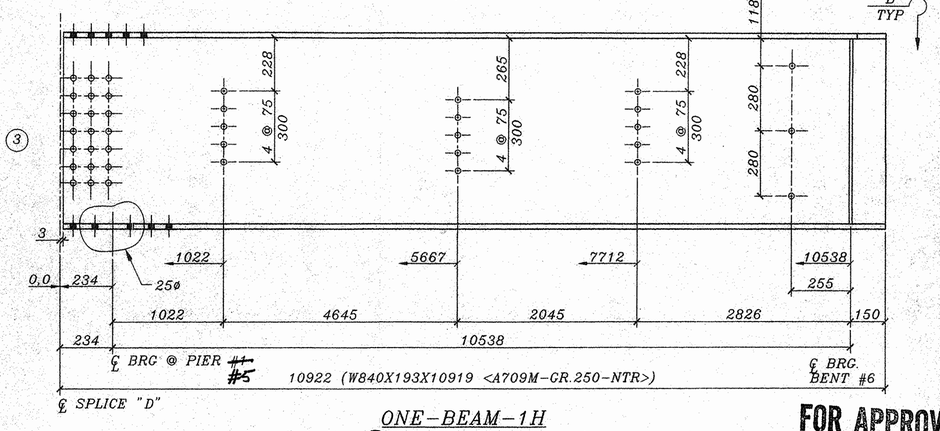

ONE-BEAM-1H

LINE (3) BENT #6 TO SPLICE "D"

SHOP PLANS

Indiana Department of Highways

APPROVED AS NOTED

SUBJECT TO CONDITIONS WRITTEN BELOW

DATE: 7/15/97 CKD. BY MM

NOTE: THIS DRAWING CHECKED FOR DESIGN FEATURES ONLY. CONTRACTOR IS RESPONSIBLE FOR DIMENSIONS, ACCURACY, AND FIT OF WORK.

FOR APPROVAL

DATE JUL 08 1997

NOTE:

1 - ALL MATERIAL ON THIS SHEET TO BE A709M GR.250 UNLESS NOTED
2 - NTR INDICATES MATERIAL TO MEET "SUPPLEMENTAL REQUIREMENTS FOR NOTCH TOUGHNESS ZONE 2".
3 - DRILL ALL SPLICE HOLES 24ø FOR 22ø A325 BOLTS FROM SOLID @ LAYDOWN. USE SPLICE PLATES AS TEMPLATES (TYP).
4 - ALL BEAMS NATURAL CAMBER UP. (TYP.)
5 - ALL DIMENSIONS GIVEN IN MILLIMETERS(mm).
← RUNNING DIMENSIONS

CONTRACT NO.....B-23076
PROJECT NO.....STP-4075(3)
STRUCTURE NO.....B-75-4883B
COUNTY.....STARKE
STATE.....INDIANA

THIS DRAWING AND ALL INFORMATION THEREON IS THE PROPERTY OF INDIANA STEEL & ENGINEERING CORP. AND IS CONFIDENTIAL AND MUST NOT BE MADE PUBLIC OR COPIED WITHOUT THEIR EXPRESSED WRITTEN AUTHORITY AND IS SUBJECT TO RECALL UPON THEIR DEMAND.

ERECTOR NOTE:
(1) INSTALL MEMBERS WITH MARK AT END SHOWN ON PLAN
(2)

HOLES	BOLTS	UNLESS NOTED
24ø	22ø A325	

APP.	APP. RECD.	RE-APP.
SHOP	DIST.	ERECTOR


ARCHITECT: INDIANA DEPARTMENT OF TRANSPORTATION
DR. BY SEAN DATE 7/7/97
CHK. JAKN DATE 7-8-97

CUSTOMER: JACK ISOM CONSTRUCTION COMPANY, INC.
JOB LOCATION: SEE ABOVE

SHOP PAINT: ZINC PRIMER


INDIANA STEEL & ENGINEERING CORP.
957 J Street - P.O. Box 668 - Area 812 275-3363
BEDFORD, INDIANA 47421

SH. OF
JOB NO. B-2499
DRAWING NO. 1

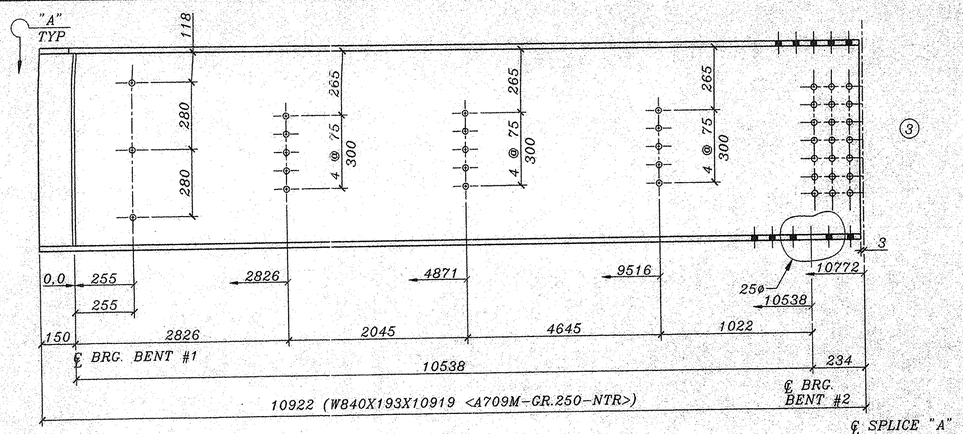


ONE-BEAM-2A

LINE (4) BENT #1 TO SPLICE "A"

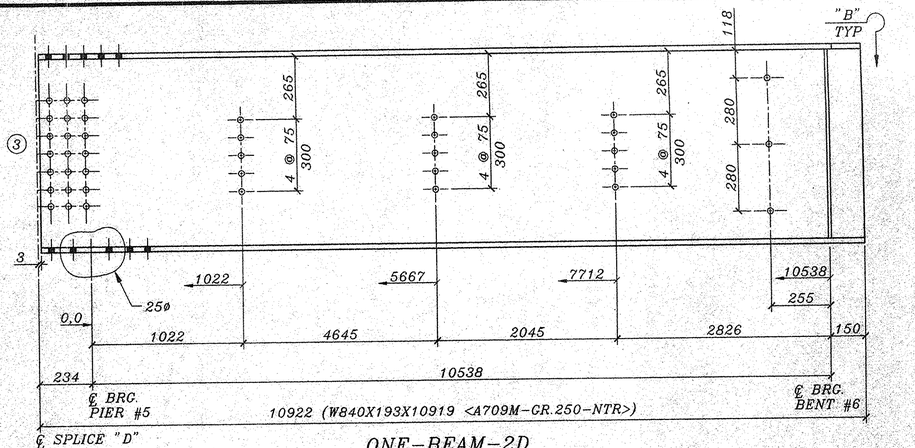


ONE-BEAM-2D

LINE (4) BENT #6 TO SPLICE "D"

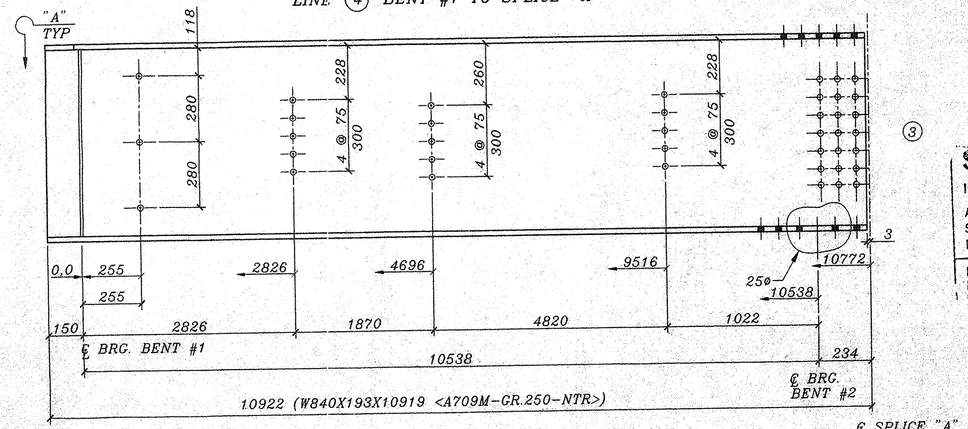


ONE-BEAM-2B

LINE (6) BENT #1 TO SPLICE "A"

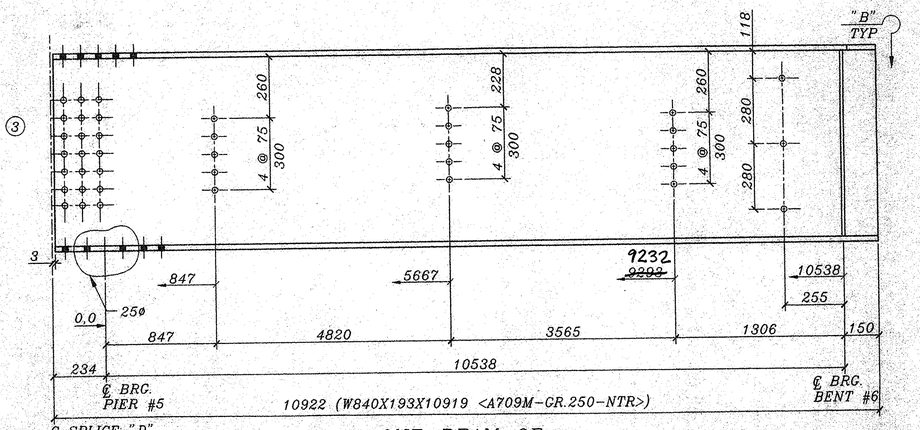


ONE-BEAM-2E

LINE (6) BENT #6 TO SPLICE "D"

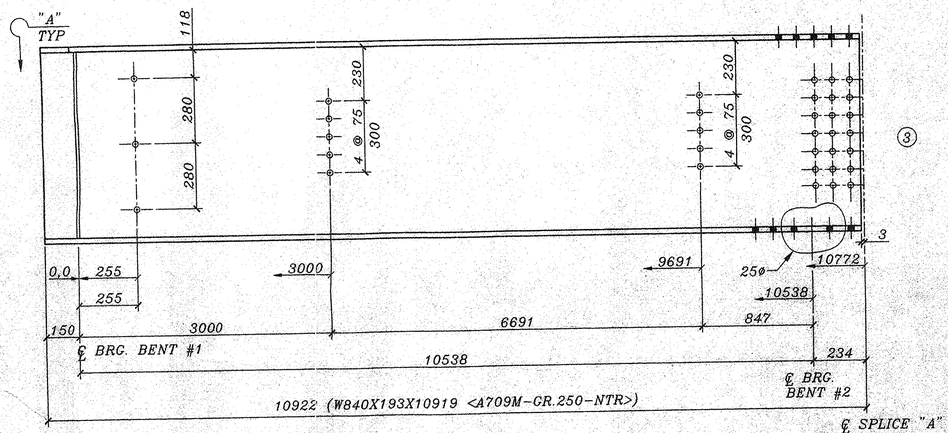


ONE-BEAM-2C


LINE (7) BENT #1 TO SPLICE "A"

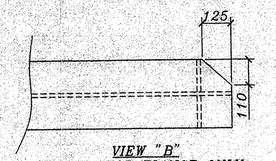


VIEW "B"
NOTCH TOP FLANGE ONLY

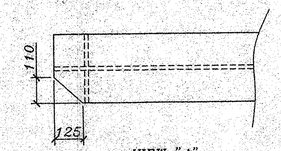

VIEW "A"
NOTCH TOP FLANGE ONLY

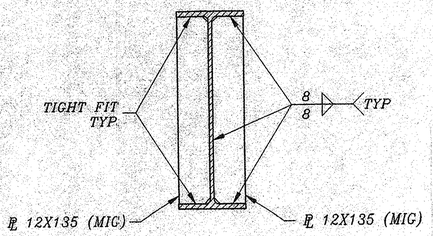

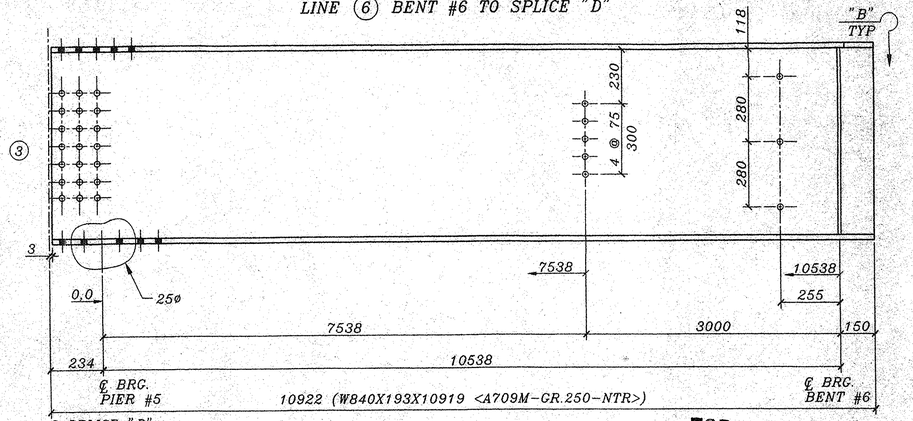

ONE-BEAM-2G

LINE (7) BENT #6 TO SPLICE "D"

SHOP PLANS
Indiana Department of Highways
APPROVED AS NOTED
SUBJECT TO CONDITIONS WRITTEN BELOW
DATE: 7/15/97 CKD. BY MM

NOTE: THIS DRAWING CHECKED FOR DESIGN FEATURES ONLY. CONTRACTOR IS RESPONSIBLE FOR DIMENSIONS, ACCURACY, AND FIT OF WORK.

FOR APPROVAL
DATE JUL 08 1997

NOTE:

1 - ALL MATERIAL ON THIS SHEET TO BE A709M GR.250 UNLESS NOTED
2 - NTR INDICATES MATERIAL TO MEET "SUPPLEMENTAL REQUIREMENTS FOR NOTCH TOUGHNESS ZONE 2".
3 - DRILL ALL SPLICE HOLES 24ø FOR 22ø A325 BOLTS FROM SOLID @ LAYDOWN. USE SPLICE PLATES AS TEMPLATES (TYP).
4 - ALL BEAMS NATURAL CAMBER UP. (TYP.)
5 - ALL DIMENSIONS GIVEN IN MILLIMETERS(mm).
← RUNNING DIMENSIONS.

CONTRACT NO.....B-23076
PROJECT NO.....STP-4075(3)
STRUCTURE NO.....8-75-4883B
COUNTY.....STARKE
STATE.....INDIANA

THIS DRAWING AND ALL INFORMATION THEREON IS THE PROPERTY OF INDIANA STEEL & ENGINEERING CORP. AND IS CONFIDENTIAL AND MUST NOT BE MADE PUBLIC OR COPIED WITHOUT THEIR EXPRESSED WRITTEN CONSENT AND IS SUBJECT TO RECALL UPON THEIR DEMAND.


ERECTOR NOTE:
(1) INSTALL MEMBERS WITH MARK AT END SHOWN ON PLAN
(2)

HOLES 24ø | BOLTS 22ø A325 UNLESS NOTED

1	4	APP.	APP. RECD.	RE-APP.	ARCHITECT INDIANA DEPARTMENT OF TRANSPORTATION	CUSTOMER JACK ISOM CONSTRUCTION CO., INC.	SHOP PAINT ZINC PRIMER
2	5	SHOP	DIST.	ERECTOR	DR. BY SEAN DATE 6/16/97 CHK. JAKN DATE 7-7-97	JOB LOCATION SEE ABOVE	

INDIANA STEEL & ENGINEERING CORP.
957 J Street - P.O. Box 668 - Area 812 275-3363
BEDFORD, INDIANA 47421

SH. OF | JOB NO. B-2499 | DRAWING NO. 2

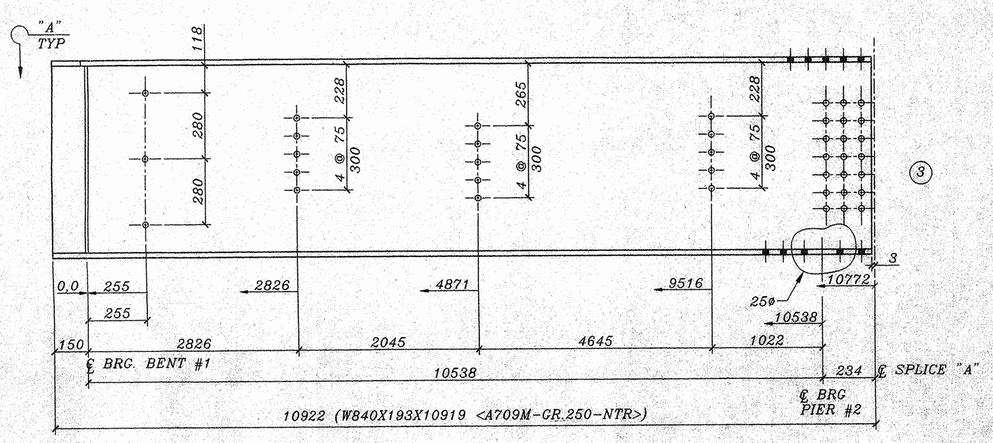


ONE-BEAM-3A

LINE (5) BENT #1 TO SPLICE "A"



VIEW "A"
NOTCH TOP FLANGE ONLY

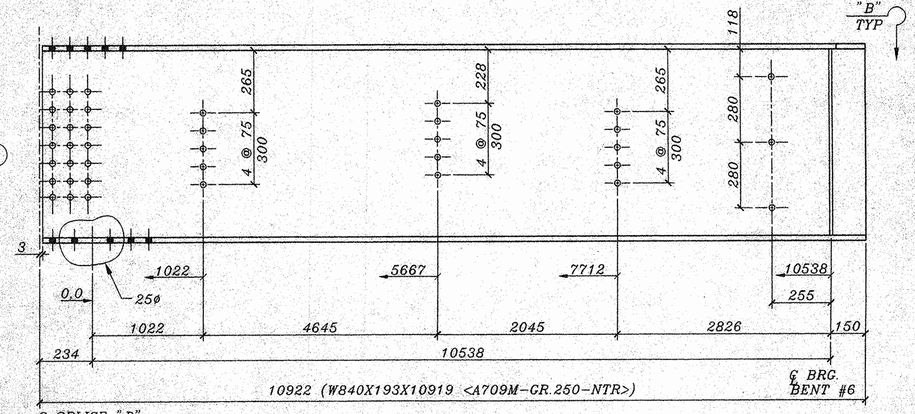


ONE-BEAM-3B

LINE (5) BENT #6 TO SPLICE "D"



VIEW "B"
NOTCH TOP FLANGE ONLY

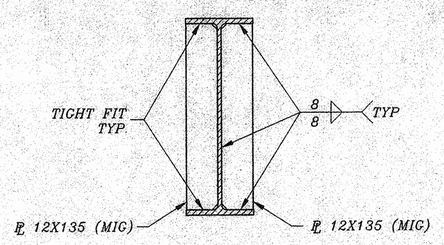

SHOP PLANS
Indiana Department of Highways
APPROVED
SUBJECT TO CONDITIONS WRITTEN BELOW
DATE: 7/15/97 CKD. BY: MM
NOTE: THIS DRAWING CHECKED FOR DESIGN FEATURES ONLY. CONTRACTOR IS RESPONSIBLE FOR DIMENSIONS, ACCURACY, AND FIT OF WORK.

FOR APPROVAL
DATE JUL 08 1997

CONTRACT NO.....B-23076
PROJECT NO.....STP-4075(3)
STRUCTURE NO.....B-75-4883B
COUNTY.....STARKE
STATE.....INDIANA

NOTE:
1 - ALL MATERIAL ON THIS SHEET TO BE A709M GR.250 UNLESS NOTED
2 - NTR INDICATES MATERIAL TO MEET "SUPPLEMENTAL REQUIREMENTS FOR NOTCH TOUGHNESS ZONE 2".
3 - DRILL ALL SPLICE HOLES 24ø FOR 22ø A325 BOLTS FROM SOLID @ LAYDOWN. USE SPLICE PLATES AS TEMPLATES (TYP).
4 - ALL BEAMS NATURAL CAMBER UP. (TYP.)
5 - ALL DIMENSIONS GIVEN IN MILLIMETERS(mm).
←— RUNNING DIMENSIONS

THIS DRAWING AND ALL INFORMATION THEREON IS THE PROPERTY OF INDIANA STEEL & ENGINEERING CORP. AND IS CONFIDENTIAL AND MUST NOT BE MADE PUBLIC OR COPIED WITHOUT THEIR EXPRESSED WRITTEN AUTHORITY AND IS SUBJECT TO RECALL UPON THEIR DEMAND.

ERECTOR NOTE:
(1) INSTALL MEMBERS WITH MARK AT END SHOWN ON PLAN
(2)

HOLES 24ø BOLTS 22ø A325 UNLESS NOTED

1	4	APP.	APP. RECD.	RE-APP.	ARCHITECT INDIANA DEPARTMENT OF TRANSPORTATION		CUSTOMER JACK ISOM CONSTRUCTION COMPANY, INC.	SHOP PAINT ZINC PRIMER	
2	5	SHOP	DIST.	ERECTOR	DR. BY SEAN DATE 7/7/97	CHK. JAXN DATE 7-7-97	JOB LOCATION SEE ABOVE		

INDIANA STEEL & ENGINEERING CORP.
957 J Street - P.O. Box 668 - Area 812 275-3363
BEDFORD, INDIANA 47421

SH. OF JOB NO. B-2499 DRAWING NO. 3