UTILITIES

NO UTILITIES PRESENT

GENERAL NOTES

INDEX

SHEET NO.	DRAWINGS INDEX
1	TITLE
2	INDEX
3-6	MAINTENANCE OF TRAFFIC
7	PAVEMENT MARKINGS DETAIL
8-10	GENERAL PLAN
11	BRIDGE SUMMARY OF QUANTITIES

REVISIONS

SHEET NO.	DATE	REVISED
2	09/24/2026	REVISIONS TABLE UPDATED
7	09/24/2026	PAVEMENT MARKING MATERIAL UPDATED
11	09/24/2026	PAVEMENT MARKING MATERIAL UPDATED

Know what's **below.**
Call before you dig.

INDIANA UNDERGROUND
1-800-382-5544 OR CALL 811
24 HOURS A DAY 7 DAYS A WEEK

09/24/2026 - REVISIONS TABLE UPDATED

MARIAH PAIGE FENIMORE
REGISTERED
PE12500349
STATE OF INDIANA
PROFESSIONAL ENGINEER

RECOMMENDED FOR APPROVAL Mariah Fenimore 6/2/2026
DESIGN ENGINEER DATE


DESIGNED: EMS DRAWN: EMS
CHECKED: MPF CHECKED: MPF

INDIANA
DEPARTMENT OF TRANSPORTATION

GENERAL NOTES AND INDEX

HORIZONTAL SCALE	BRIDGE FILE NO.
N/A	050-15-002100 CEBL
VERTICAL SCALE	DESIGNATION NO.
N/A	2200671
	SHEETS
	2 of 11
	CONTRACT NO.
	B-44450

S:\COL\4000--4099\4060\737\Drawings\CAD\Plan\Sht_Index.dgn 9/24/2026 4:57:27 PM gregsz

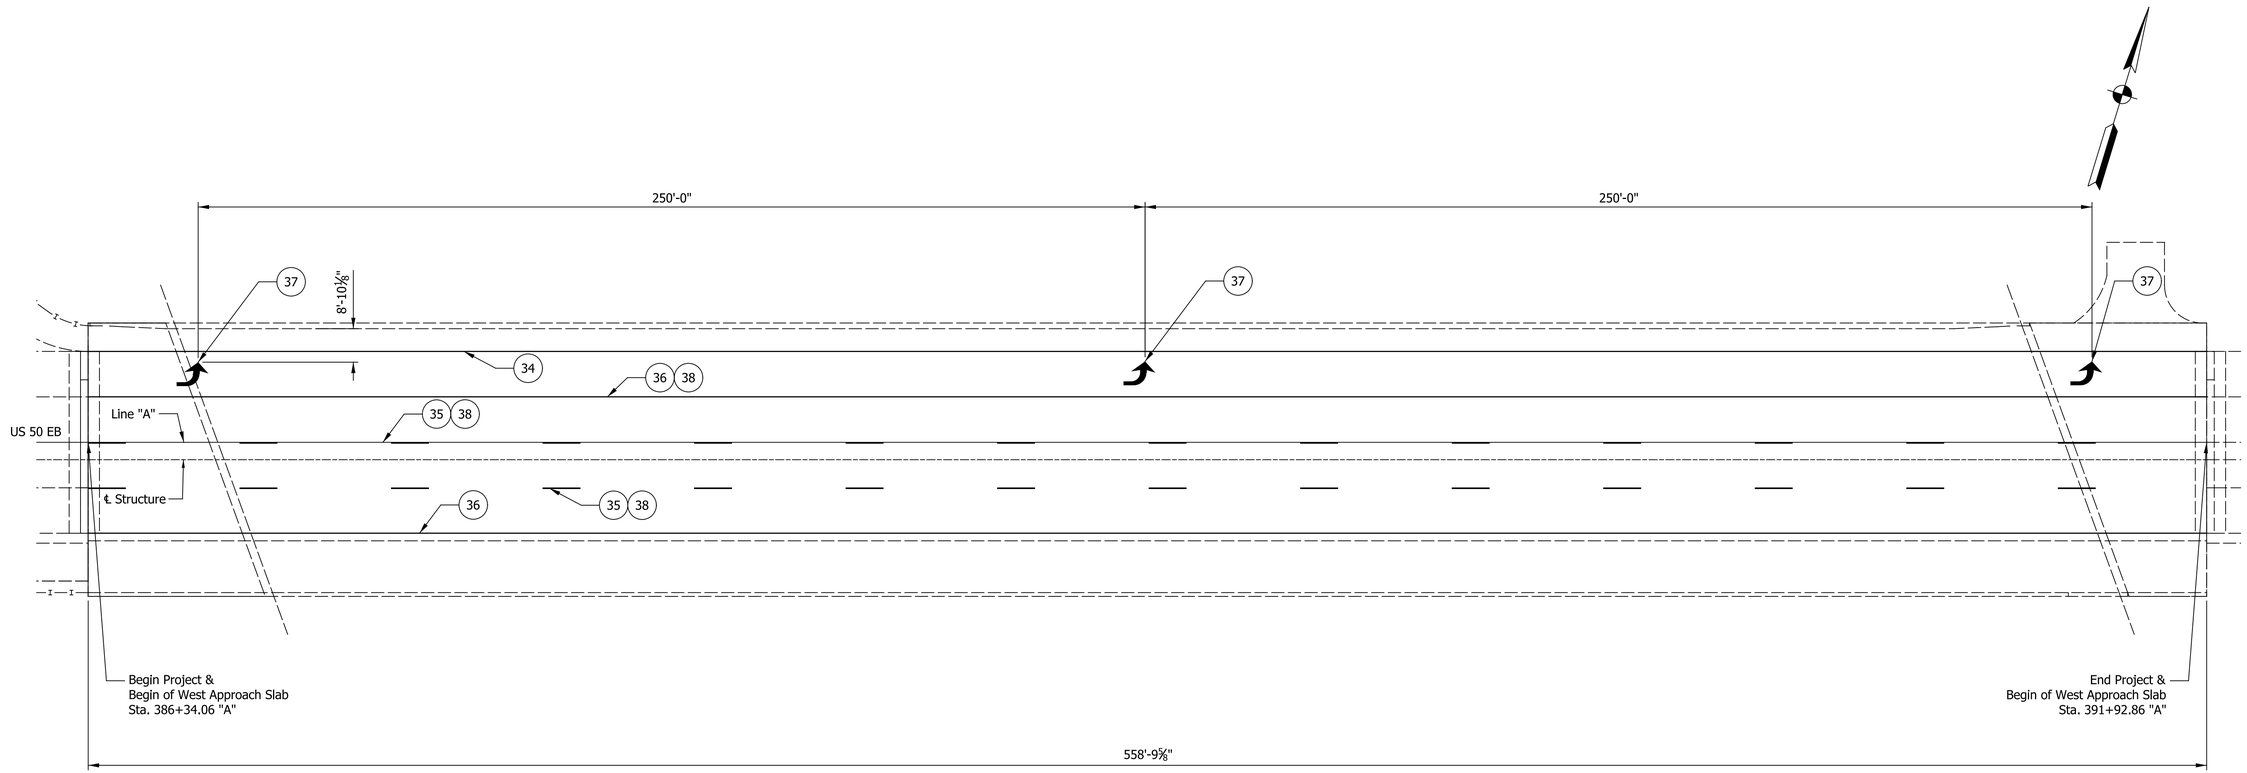

PLAN

LEGEND

34	~~Line, Preformed Plastic Solid Yellow, 6 in.~~	Line, Multi-Component, Solid, Yellow, 6 in.
35	~~Line, Preformed Plastic Broken White, 6 in.~~	Line, Multi-Component, Broken, White, 6 in.
36	~~Line, Preformed Plastic Solid White, 6 in.~~	Line, Multi-Component, Solid, White, 6 in.
37		Pavement Message Marking, Multi-Component, Lane Indication Arrow
38		6 Prismatic Reflectors (White / Red)

NOTES

1. Prismatic Reflectors of Raised Snowplowable Pavement Markers (RSPM) to be replaced within project limits.
2. All pavement markings on bridge deck and approach slabs to be removed and replaced.

09/24/2026 - PAVEMENT MARKING MATERIAL UPDATED

MARIAH PAIGE FENIMORE
REGISTERED
PE12500349
STATE OF INDIANA
PROFESSIONAL ENGINEER

RECOMMENDED FOR APPROVAL Mariah Fenimore 6/2/2026
DESIGN ENGINEER DATE

DESIGNED: EMS DRAWN: EMS
CHECKED: MPF CHECKED: MPF

INDIANA
DEPARTMENT OF TRANSPORTATION

PAVEMENT MARKINGS DETAIL
US 50 OVER TANNERS CREEK

HORIZONTAL SCALE	BRIDGE FILE NO.
1" = 20'	050-15-002100 CEBL
VERTICAL SCALE	DESIGNATION NO.
N/A	2200671
	SHEETS
	7 of 11
	CONTRACT NO.
	B-44450

9/24/2026 4:57:28 PM gregsz
S:\COL\4000—4099\4060\737\Drawings\CAD\Plan\Sht_Pavement_Markings.dgn

SUMMARY OF BRIDGE QUANTITIES

ITEM	CONCRETE				CONCRETE RAILING CLASS C	REINF. BARS	REINF. BARS, EPOXY COATED	RAILING STEEL	BARRIER DELIN-EATORS	WARRANTED POLYMERIC OVERLAY	DENSE GRADED SUBBASE	STRUCT. STEEL	ANCHOR PLATES MK-AP	PILES										GRATES BASINS, & FITTINGS, CAST IRON	EXP. JOINT TYPE __	CONC. STR. MEMBERS		SURFACE SEAL**
	CLASS C	CLASS A	CLASS B											STEEL PIPE (SIZE)	STEEL PIPE EPOXY COATED (SIZE)	STEEL H (SIZE)	STEEL H EPOXY COATED	STEEL H REINF. CONC. ENCASED	TEST PILE, DYNAMIC, PRODUCTION	TEST PILE, DYNAMIC, RESTRIKE	PILE SHOE (SIZE)	PILE TIP STEEL H (SIZE)	CORED HOLE IN ROCK				BOX BEAM TYPE & SIZE	I BEAM TYPE & SIZE	
	SUPERSTR	SUBSTR	ABOVE FTG.	IN FTG.																		NO.	LFT				
	CYS	CYS	CYS	CYS	CYS	LBS	LBS	LFT	EACH	SYS	CYS	LBS	EACH	LFT	LFT	LFT	LFT	LFT	LFT	EACH	EACH	EACH			LBS	LFT	LFT	LFT	SFT
E RCBA																													1,719
W RCBA																													1,719
SIDEWALK																													7,933
SUPERSTRUCTURE										3,062																			
CONCRETE RAILING PS-1																													3,991
CONCRETE RAILING TYPE FT																													5,122
TOTALS										3,062																			20,484

** Estimated Quantity

PAVEMENT MARKINGS TABLE

LOCATION		~~LINE, PREFORMED PLASTIC~~ LINE, MULTI-COMPONENT				PAVEMENT MESSAGE MARKING, MULTI-COMPONENT		PRISMATIC REFLECTORS	
		BROKEN WHITE 6 IN.	BROKEN YELLOW 6 IN.	SOLID YELLOW 6 IN.	SOLID WHITE 6 IN.	LANE INDICATION ARROW (LT.)	RR CROSSING	YELLOW / RED	WHITE / RED
LT./RT.	STATION	FT	FT	FT	FT	EACH	EACH	EACH	EACH
LT.	386+34.06 "A" to 391+92.86 "A"			559	559	3			6
Mid.	386+34.06 "A" to 391+92.86 "A"	140							6
Rt.	386+34.06 "A" to 391+92.86 "A"	140			559				6
TOTALS		280		559	1,118	3			18

09/24/2026 - PAVEMENT MARKING MATERIAL UPDATED

MARIAH PAIGE FENIMORE REGISTERED PE12500349 STATE OF INDIANA PROFESSIONAL ENGINEER

RECOMMENDED FOR APPROVAL Mariah Fenimore 6/2/2026
DESIGN ENGINEER DATE

DESIGNED: EMS DRAWN: EMS
CHECKED: MPF CHECKED: MPF

INDIANA DEPARTMENT OF TRANSPORTATION

BRIDGE SUMMARY
US 50 OVER TANNERS CREEK

HORIZONTAL SCALE	BRIDGE FILE NO.
N/A	050-15-002100 CEBL
VERTICAL SCALE	DESIGNATION NO.
N/A	2200671
	SHEETS
	11 of 11
	CONTRACT NO.
	B-44450

gregsz
4:57:28 PM
9/24/2026
S:\COL\4000—4099\4060\737\Drawings\CAD\Plan\Sht_Bridge_Summary.dgn